
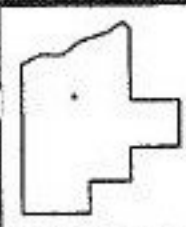


RASTER

PARENT PARCEL: 06-23-010-103-014  
CHILD PARCEL:  
STARTING POINT: NORTHWEST CORNER OF 06-23-010-103-014

NO. 00681-A

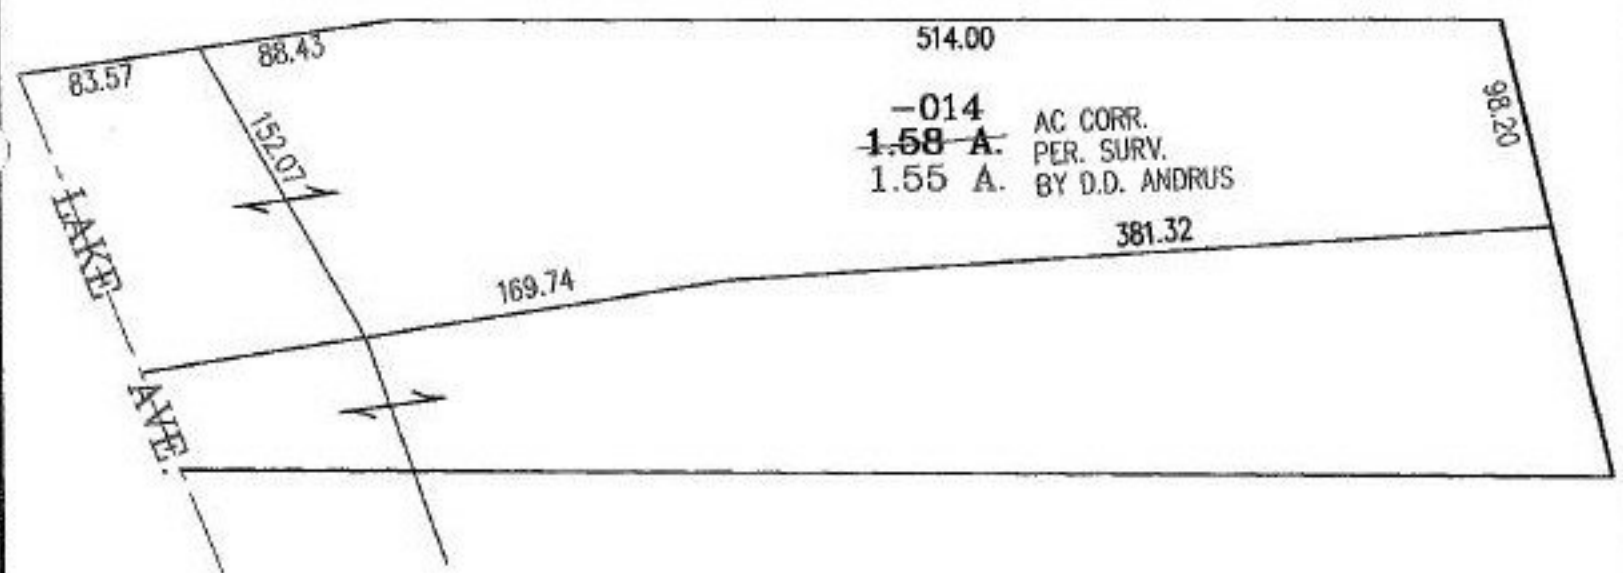

SPLITS/DEEDS PROCESSED  
LORAIN COUNTY TAX MAP DEPARTMENT  
226 MIDDLE AVE. ELYRIA, OHIO

SURVEYED BY: D.D. ANDRUS  
CLOSURE: 00:10:00  
MAP PAGE(S): 6-25  
APPROVED BY: RRM DATE: 6-25-02  
SCALE: 1" = 100' PRIOR INSTRUMENT: 20020813194