

RASTER


PARENT PARCEL: 21-03-000-000-028

NO. 00691-A

CHILD PARCEL:

STARTING POINT: INTERSECTION OF SOUTH LINE OF TRACT 4 AND C/L OF S.R.58

TRACT 4
TRACT 3

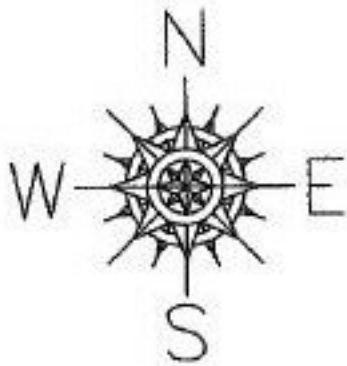

RD.

1913.63

2282.22

-027 AC. CORR.
~~37.00~~ A. PER. SURV.
36.98 A. BY T.SIMON

1191.08

2484.47

A.C. & Y. RAILROAD

5782.32

1478.88

ASHLAND - OBERLIN (S.R.58)

-028 AC. CORR.
~~56.94~~ A. PER. SURV.
59.28 A. BY T.SIMON

3492.12

STEWART

RD.



SPLITS/DEEDS PROCESSED

LORAIN COUNTY TAX MAP DEPARTMENT
226 MIDDLE AVE. ELYRIA, OHIO

SURVEYED BY: THOMAS A. SIMON

CLOSURE: 01:10.000

MAP PAGE(S): 21-F

APPROVED BY: RRM DATE: 3-20-02

SCALE: 1" = 500. PRIOR INSTRUMENT: