

RASTER

PARENT PARCEL: 04-00-015-110-060

CHILD PARCEL:


STARTING POINT: AT A MON BOX AT THE INTERSECTION OF THE C/L OF CENTER RD.
AND C/L OF DETROIT RD.

NO. 00693-A



CENTER RD.

DETROIT RD.

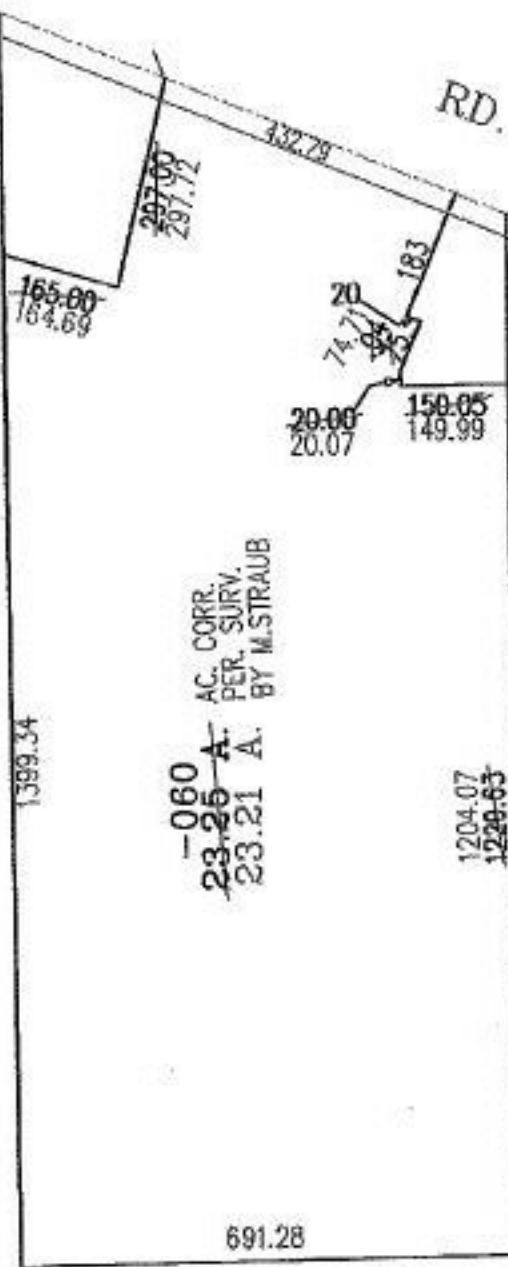

AC. CORR.
PER. SURV.
BY M. STRAUB
-060
23-25-A
23.21 A.



SPLITS/DEEDS PROCESSED
LORAIN COUNTY TAX MAP DEPARTMENT
226 MIDDLE AVE. ELYRIA, OHIO

SURVEYED BY: MICHAEL A STRAUB
CLOSURE: 02:10.000
MAP PAGE(S): 4-00-015-C&G
APPROVED BY: RBM DATE: 3-15-02
SCALE: 1" = 300 PRIOR INSTRUMENT: 20010764614