


EASTER

PARENT PARCEL: 11-00-046-000-021

NO. 00726-A

CHILD PARCEL:

STARTING POINT: C/L OF ROYALTON RD.(ELYRIA TWINSBURG RD.<SR 82>)

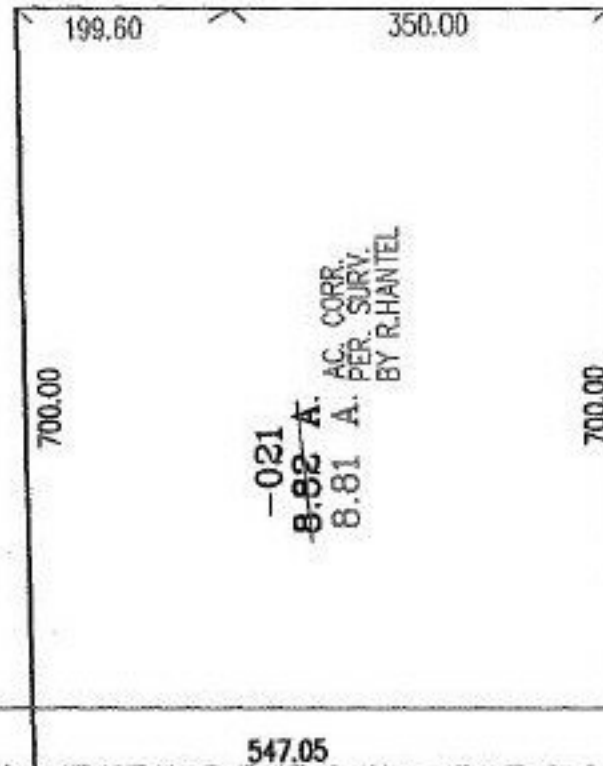

ELYRIA TWINSBURG RD. (SR 82)



SPLITS/DEEDS PROCESSED
 LORAIN COUNTY TAX MAP DEPARTMENT
 226 MIDDLE AVE. ELYRIA, OHIO

SURVEYED BY: RICHARD F. HANTEL
 CLOSURE: 01:10.000
 MAP PAGE(S): 11-C
 APPROVED BY: BRM DATE: 6-28-02
 SCALE: 1" = 200' PRIOR INSTRUMENT: DV 811/264