



RASTER

PARENT PARCEL: 04-00-019-112-045

NO. 00732-A

CHILD PARCEL:

STARTING POINT: SOUTHWEST CORNER OF SUNSET PARK SUB.(VOL.13 PG. 13)

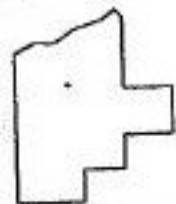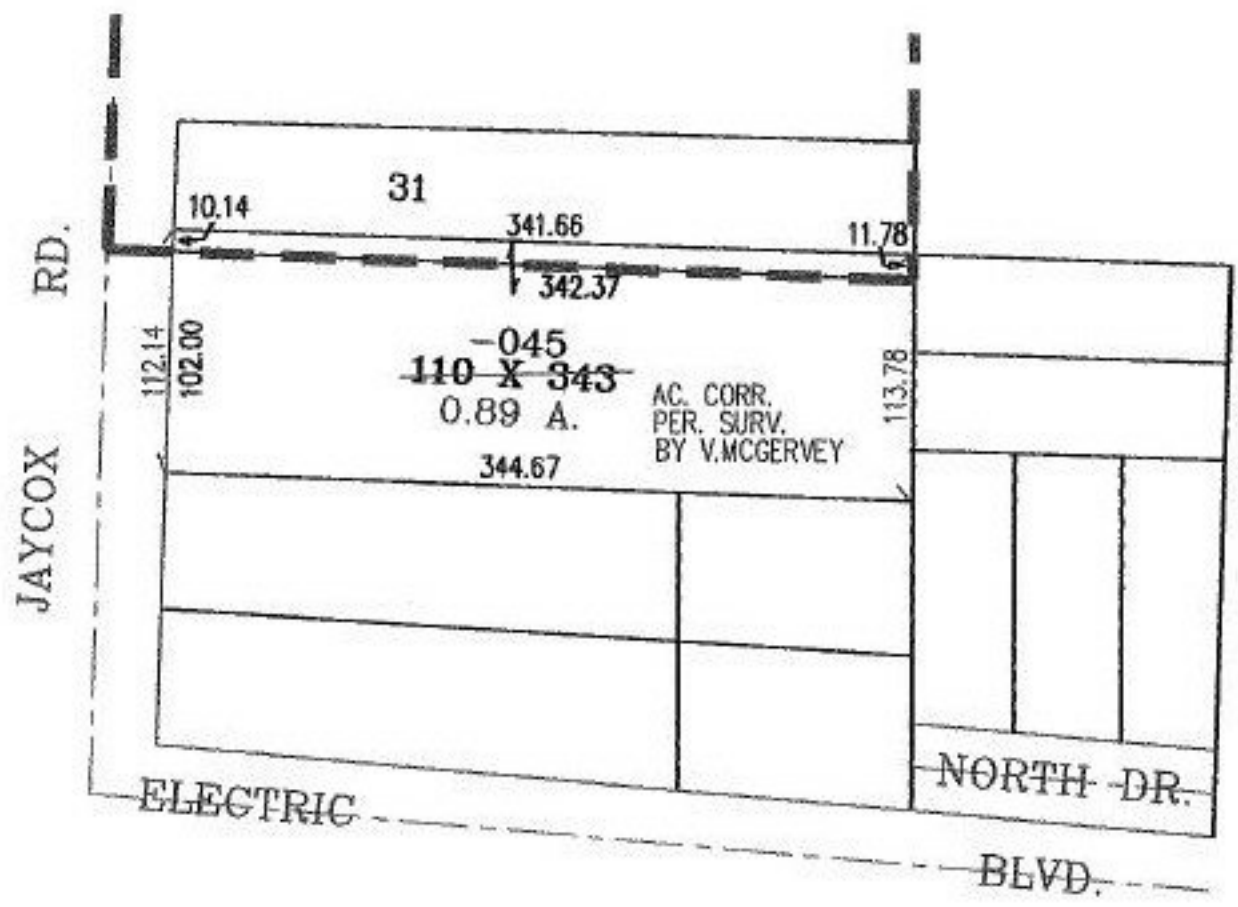

SPLITS/DEEDS PROCESSED

LORAIN COUNTY TAX MAP DEPARTMENT
226 MIDDLE AVE. ELYRIA, OHIO

SURVEYED BY: VINCENT C. MCGERVEY
 CLOSURE: .04:10.000
 MAP PAGE(S): 4-00-019-C
 APPROVED BY: BRM DATE: 7-11-02
 SCALE: 1" = 100' PRIOR INSTRUMENT: