



RASTER

PARENT PARCEL: 02-01-008-101-320 THRU -333

CHILD PARCEL:

STARTING POINT: PART OF NOTTINGHAM WOODS SUB. (VOL.36 PGS.6-7)

NO. 00756-C

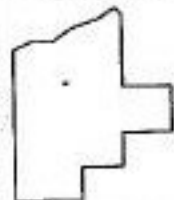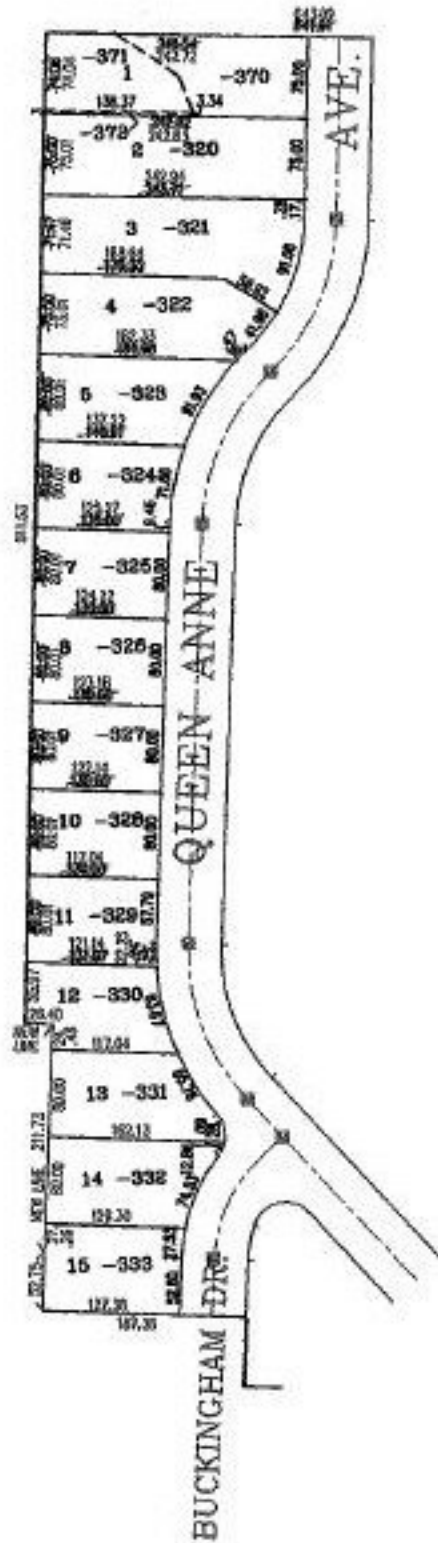

SPLITS/DEEDS PROCESSED
LORAIN COUNTY TAX MAP DEPARTMENT
226 MIDDLE AVE. ELYRIA, OHIO

SURVEYED BY: NORMAN R. HURA

CLOSURE: N/A

MAP PAGE(S): 2-01-008-A

APPROVED BY: RRM DATE: 11-14-02

SCALE: 1" = 200' PRIOR INSTRUMENT: OR 471/347