




RASTER

PARENT PARCEL: 03-00-001-701-001,-002

CHILD PARCEL:

STARTING POINT: PART OF YORKSHIRE COMMONS CONDOS PH. NO.1 (VOL.73 PGS.61-63)

NO. 00773-A

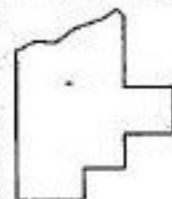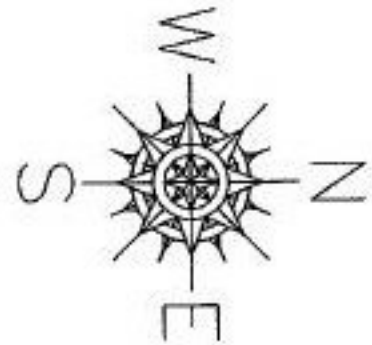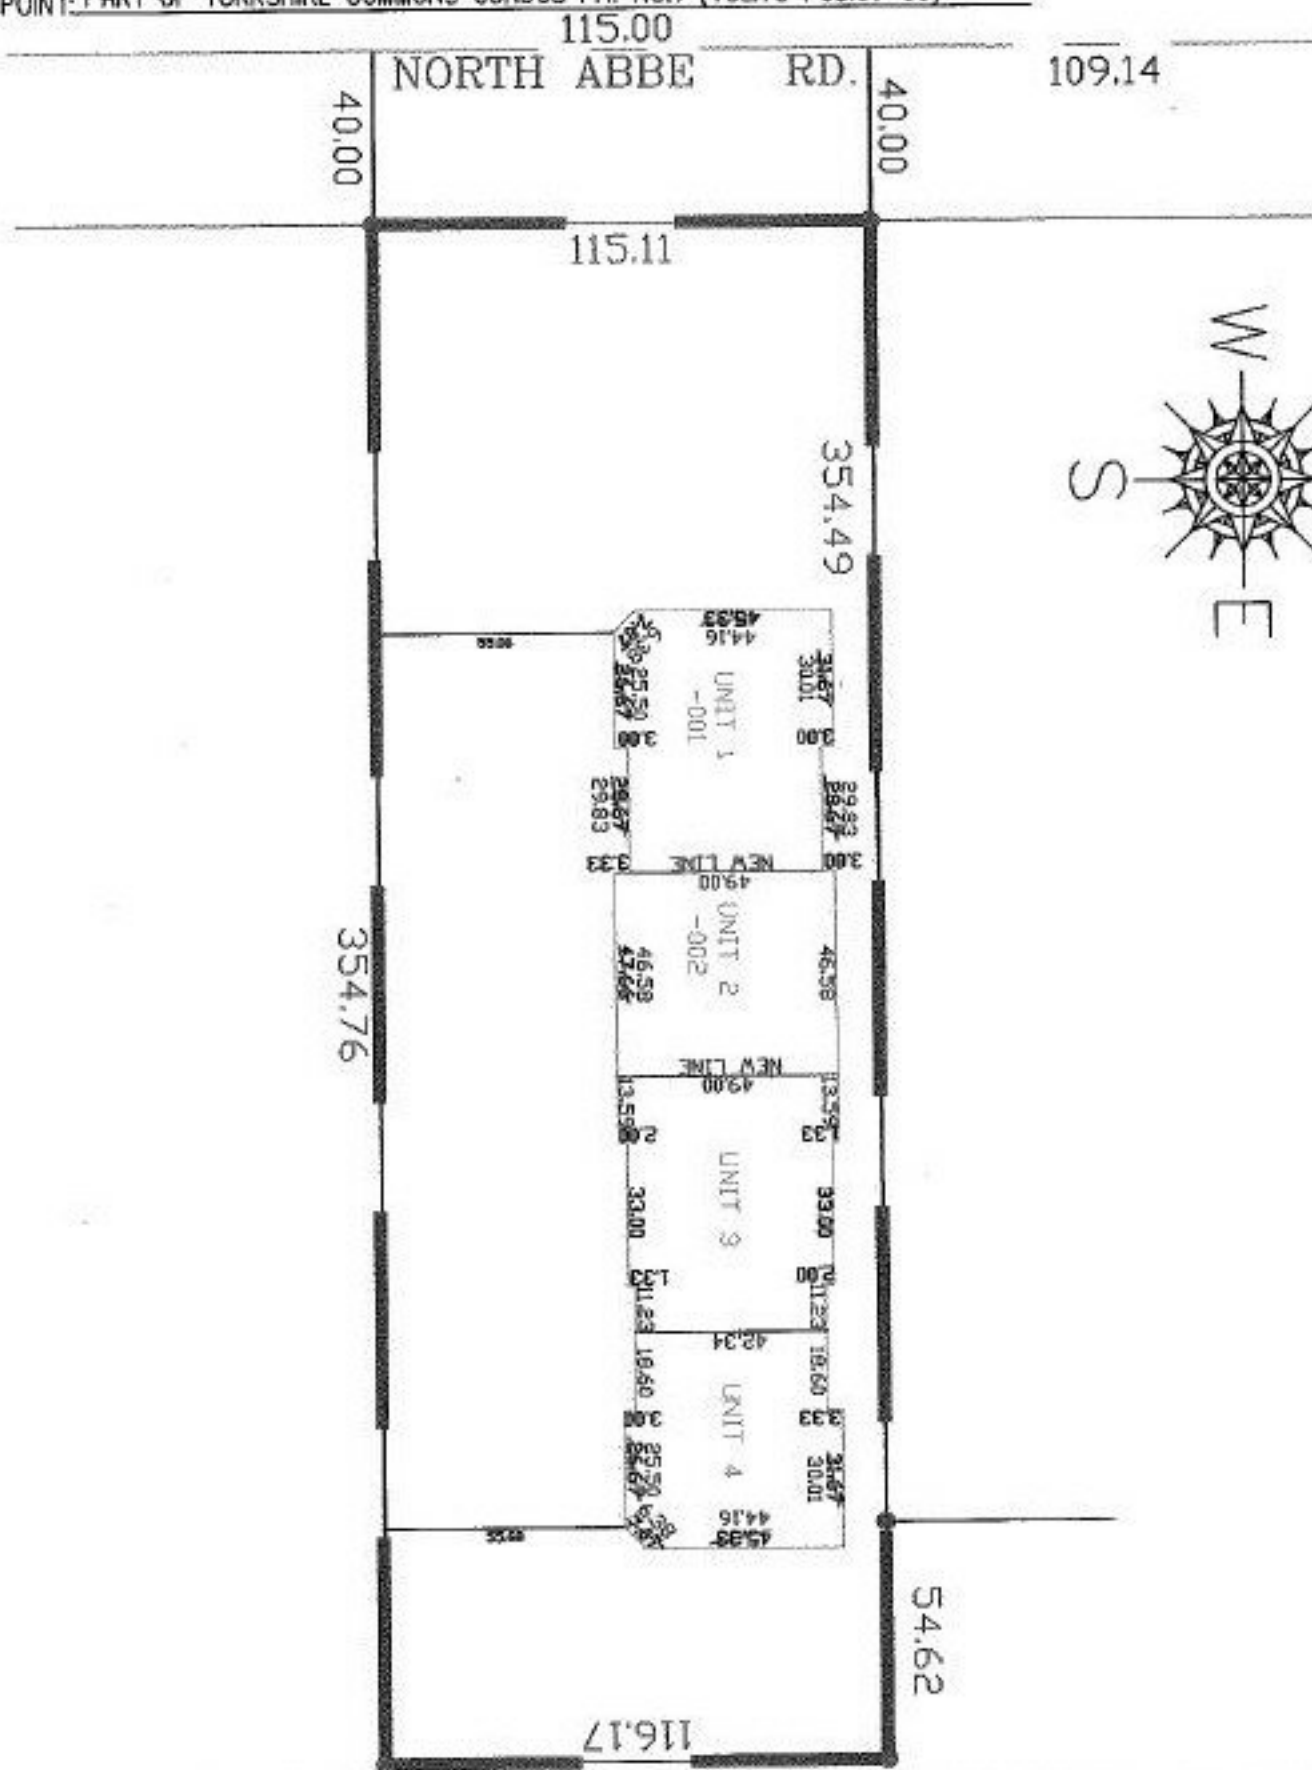

**SPLITS/DEEDS PROCESSED**  
 LORAIN COUNTY TAX MAP DEPARTMENT  
 226 MIDDLE AVE. ELYRIA, OHIO

SURVEYED BY: DAVID L. ELWELL  
 CLOSURE: N/A  
 MAP PAGE(S):  
 APPROVED BY: RRM DATE: 11-11-02  
 SCALE: 1" = 50' PRIOR INSTRUMENT: