

RASTER

PARENT PARCEL: 04-00-029-000-408,-409

CHILD PARCEL: XX-XX-XXX-XXX-XXX

STARTING POINT: INTERSECTION OF C/L OF LEAR NAGLE RD. AND C/L OF WALKER RD.

NO. 00774-A




WALKER RD.

RD.

5306.08

LEAR NAGLE

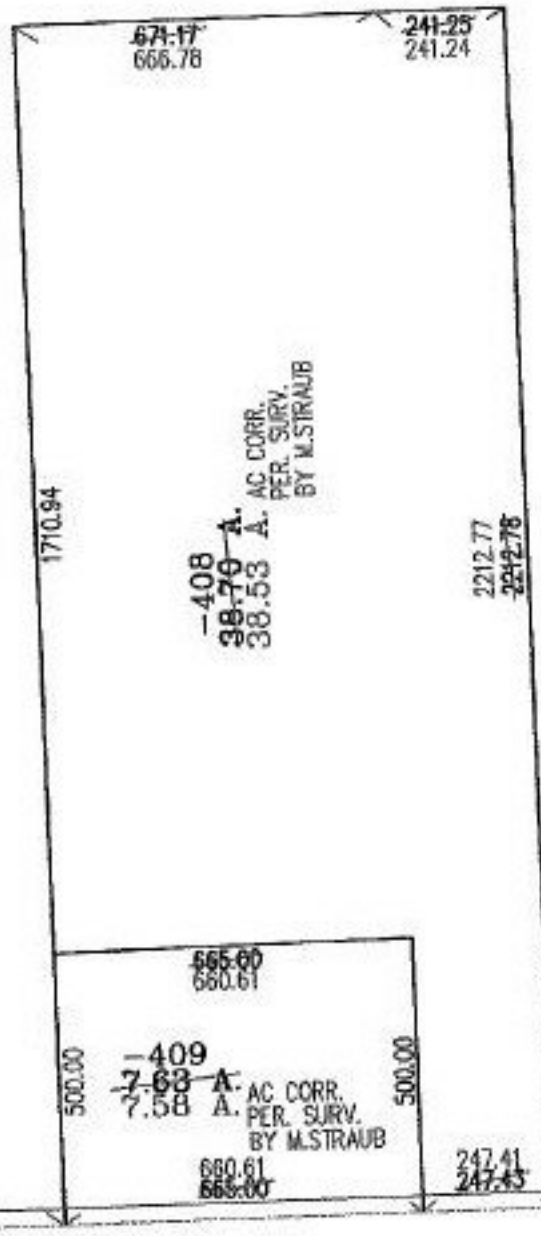

671.17
666.78

241.25
241.24

1710.94

-408
38.79 A.
38.53 A.

AC CORR.
PER. SURV.
BY M. STRAUB

2212.77
2242.78

665.60
660.61

-409
7.63 A.
7.58 A.

AC CORR.
PER. SURV.
BY M. STRAUB

660.61
665.00

247.41
247.43

1148.99

KREBS

RD.



SPLITS/DEEDS PROCESSED
LORAIN COUNTY TAX MAP DEPARTMENT
226 MIDDLE AVE. ELYRIA, OHIO

SURVEYED BY: MICHAEL A. STRAUB

CLOSURE: .02:10.000

MAP PAGE(S): 4-0

APPROVED BY: RRM DATE: 11-20-02

SCALE: 1" = 400' PRIOR INSTRUMENT: 200007096.33