


RASTER

PARENT PARCEL: 18-00-030-000-035

CHILD PARCEL:

NO. 00783-C

STARTING POINT: INTERSECTION OF C/L OF PECK-WADSWORTH RD. AND WEST LINE OF L&WV RR

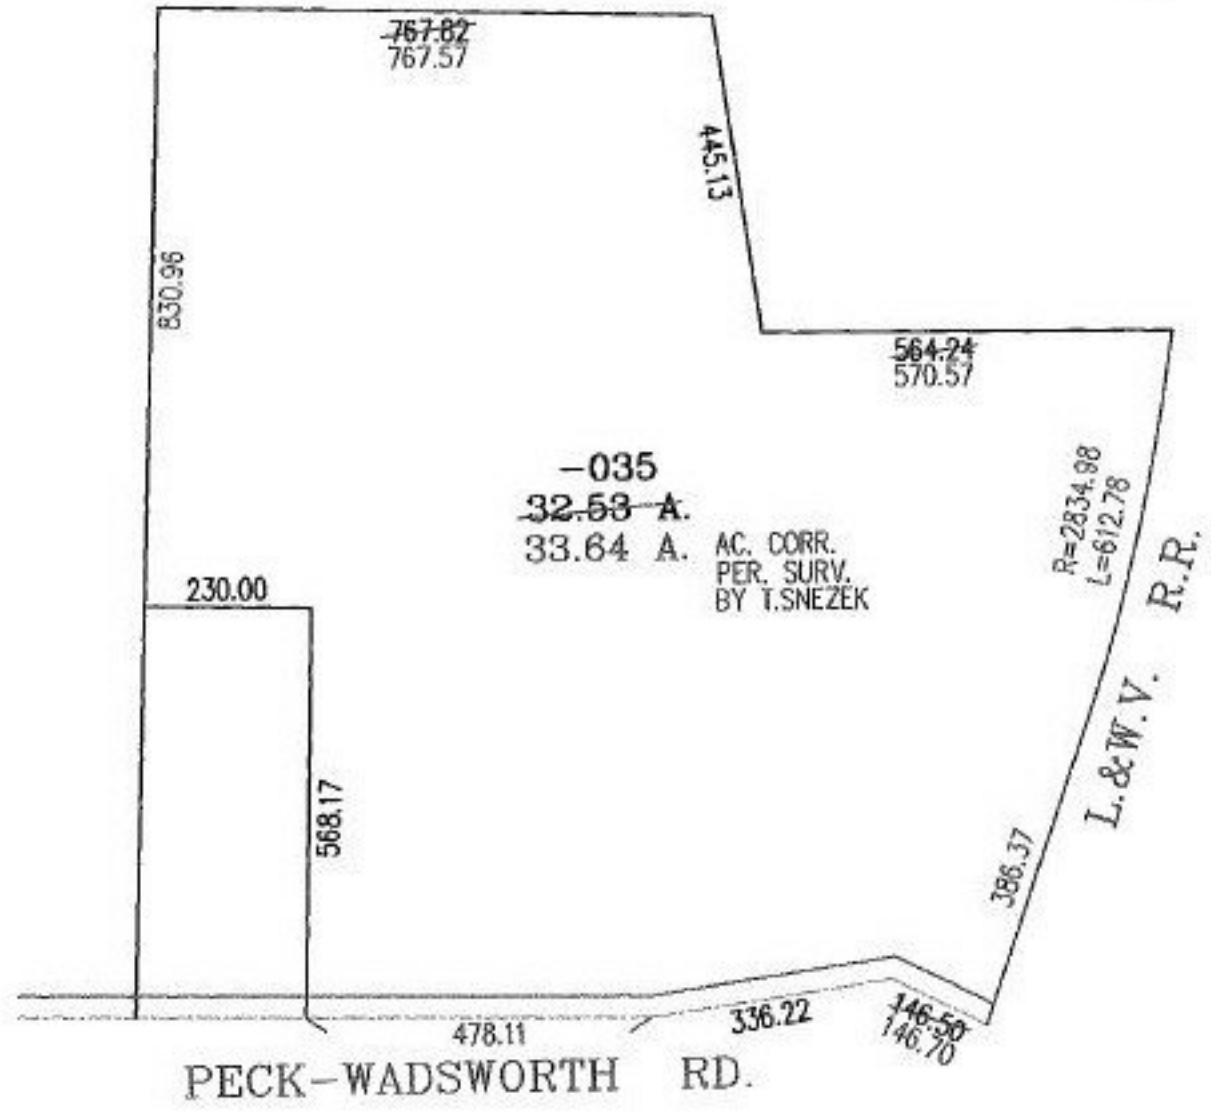

PECK-WADSWORTH RD.

L.&W.V. R.R.

-035  
32.58 A.  
33.64 A. AC. CORR.  
PER. SURV.  
BY T.SNEZEK

SURVEYED BY: THOMAS M. SNEZEK  
 CLOSURE: .01:10.000  
 MAP PAGE(S): 18-B  
 APPROVED BY: BRM DATE: 1-6-03  
 SCALE: 1" = 300' PRIOR INSTRUMENT: OR 1098/204

**SPLITS/DEEDS PROCESSED**

LORAIN COUNTY TAX MAP DEPARTMENT  
226 MIDDLE AVE. ELYRIA, OHIO

