


RASTER

PARENT PARCEL: 06-26-066-000-004

CHILD PARCEL:

STARTING POINT: EAST R.O.W. LINE OF WATER ST.

NO. 00785-C

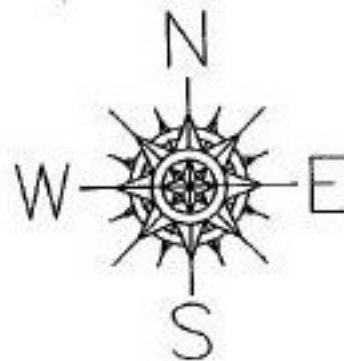

-004  
~~42.00 X 56.00~~  
 42.15 X 70.14  
 AC. CORR. PER SURV. BY DEED

SURVEYED BY: DEED  
 CLOSURE: N/A  
 MAP PAGE(S): 6-118  
 APPROVED BY: RBM DATE: 1-7-03  
 SCALE: 1" = 50' PRIOR INSTRUMENT: 20020880157

**SPLITS/DEEDS PROCESSED**

LORAIN COUNTY TAX MAP DEPARTMENT  
 226 MIDDLE AVE. ELYRIA, OHIO

