

RASTER

PARENT PARCEL: 05-00-055-000-034, -036, -009


CHILD PARCEL:

STARTING POINT: INTERSECTION OF C/L OF OBERLIN RD. AND C/L OF ACCESS STRIP OHIO TURNPIKE

NO. 00788-A

PARCELS -034 AND -036 NOW GO TO C/L NOT S/L OF THE ROAD ACCORDING TO SURVEY DONE BY CHARLES P. WARYU

NO RECORDS SHOWN FOR -009, -009 WILL BE DROPPED FROM DUP.

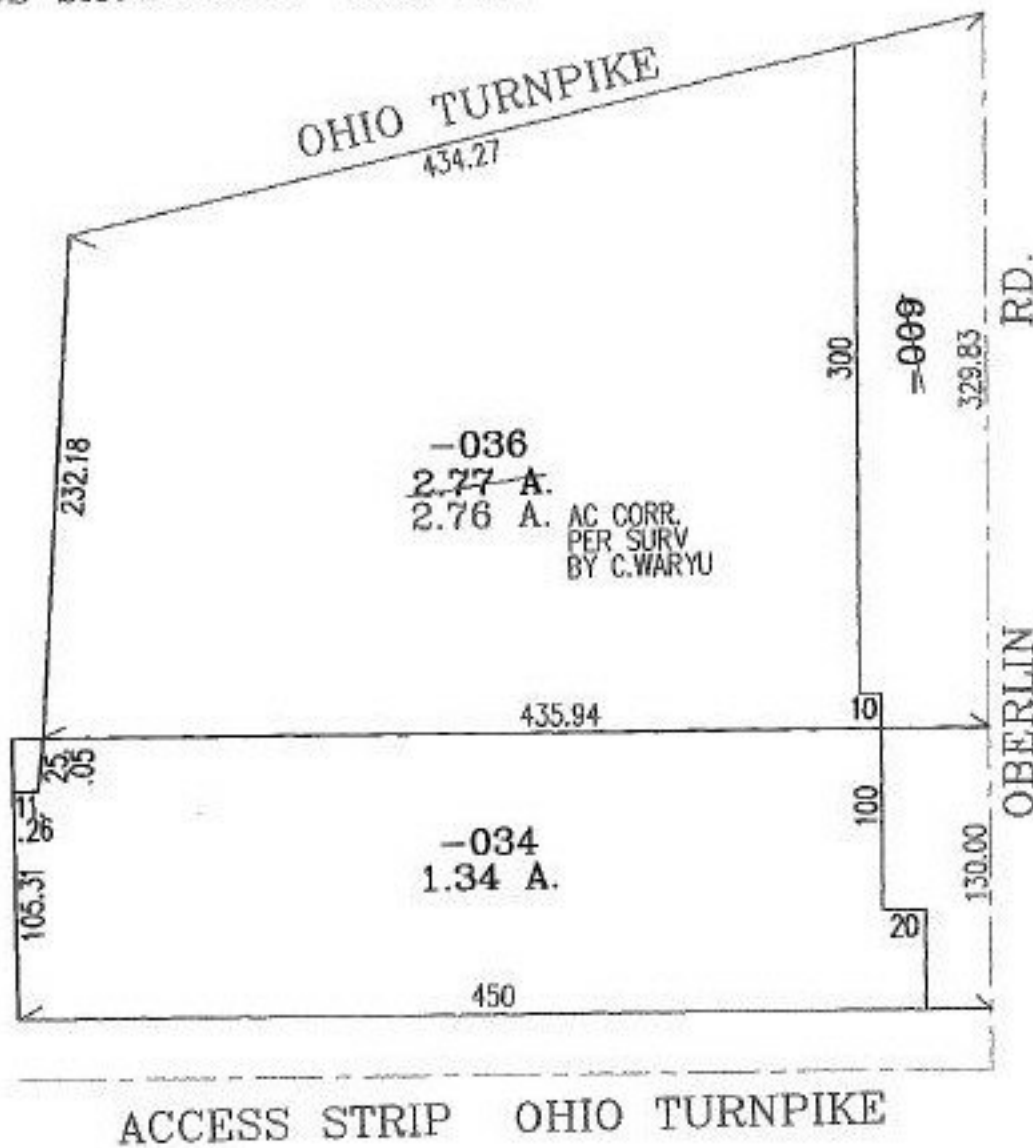

**SPLITS/DEEDS PROCESSED**

LORAIN COUNTY TAX MAP DEPARTMENT  
226 MIDDLE AVE. ELYRIA, OHIO

SURVEYED BY: CHARLES P. WARYU

CLOSURE: N/A

MAP PAGE(S): 5-6

APPROVED BY: RRM DATE: 1-31-03

SCALE: 1" = 100' PRIOR INSTRUMENT: DV 849/591