

PARENT PARCEL: 11-00-012-000-004

CHILD PARCEL: 11-00-012-000-008, -009

STARTING POINT: CENTERLINE OF BROKAW RD. & O.L. 12

NO. 00959




BROKAW

125.00

375.90

RD.

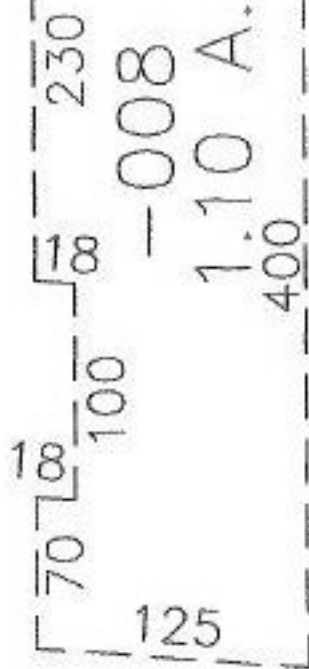

-009
27.34 A.

~~-004~~
~~28.44 A.~~

O.L. 12
O.L. 9



SPLITS/DEEDS PROCESSED
LORAIN COUNTY TAX MAP DEPARTMENT
226 MIDDLE AVE. ELYRIA, OHIO

SURVEYED BY: RICHARD D. CARLSON
CLOSURE: 0.00 : 10.000
MAP PAGE(S): 11-00-012-B
APPROVED BY: JAH DATE: 1-10-02
SCALE: 1" = 100' PRIOR INSTRUMENT: 20000679560