



RASTER

PARENT PARCEL: 06-24-045-103-039

CHILD PARCEL: 06-24-045-103-056 THRU -058

STARTING POINT: CENTERLINE OF MURRAY RIDGE RD. & O.L. 45

NO. 00967

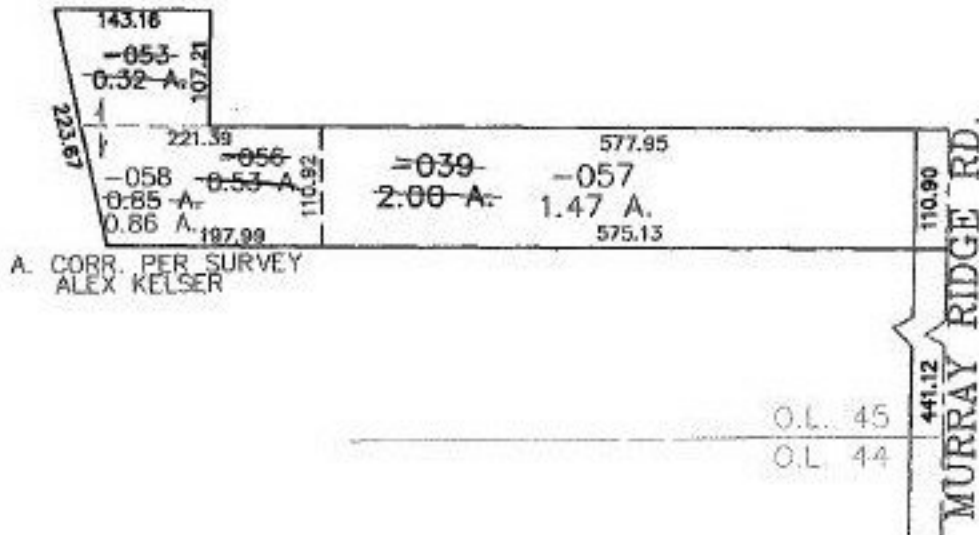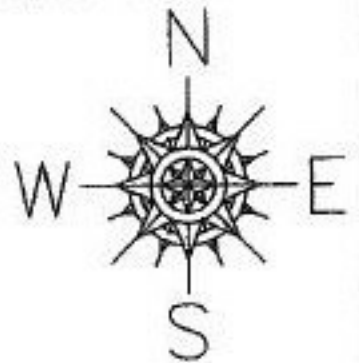

SPLITS/DEEDS PROCESSED
LORAIN COUNTY TAX MAP DEPARTMENT
226 MIDDLE AVE. ELYRIA, OHIO

SURVEYED BY: ALEX KELSER
 CLOSURE: 0.00 : 10.000
 MAP PAGE(S): 6-39
 APPROVED BY: JAH DATE: 1-18-02
 SCALE: 1" = 200' PRIOR INSTRUMENT: 20010762760