


PARENT PARCEL: 06-24-016-000-055

CHILD PARCEL: 06-24-017-102-077, 06-24-016-000-084

STARTING POINT: INTERSECTION OF O.L. 16, 17, 18, 19

NO. 00968

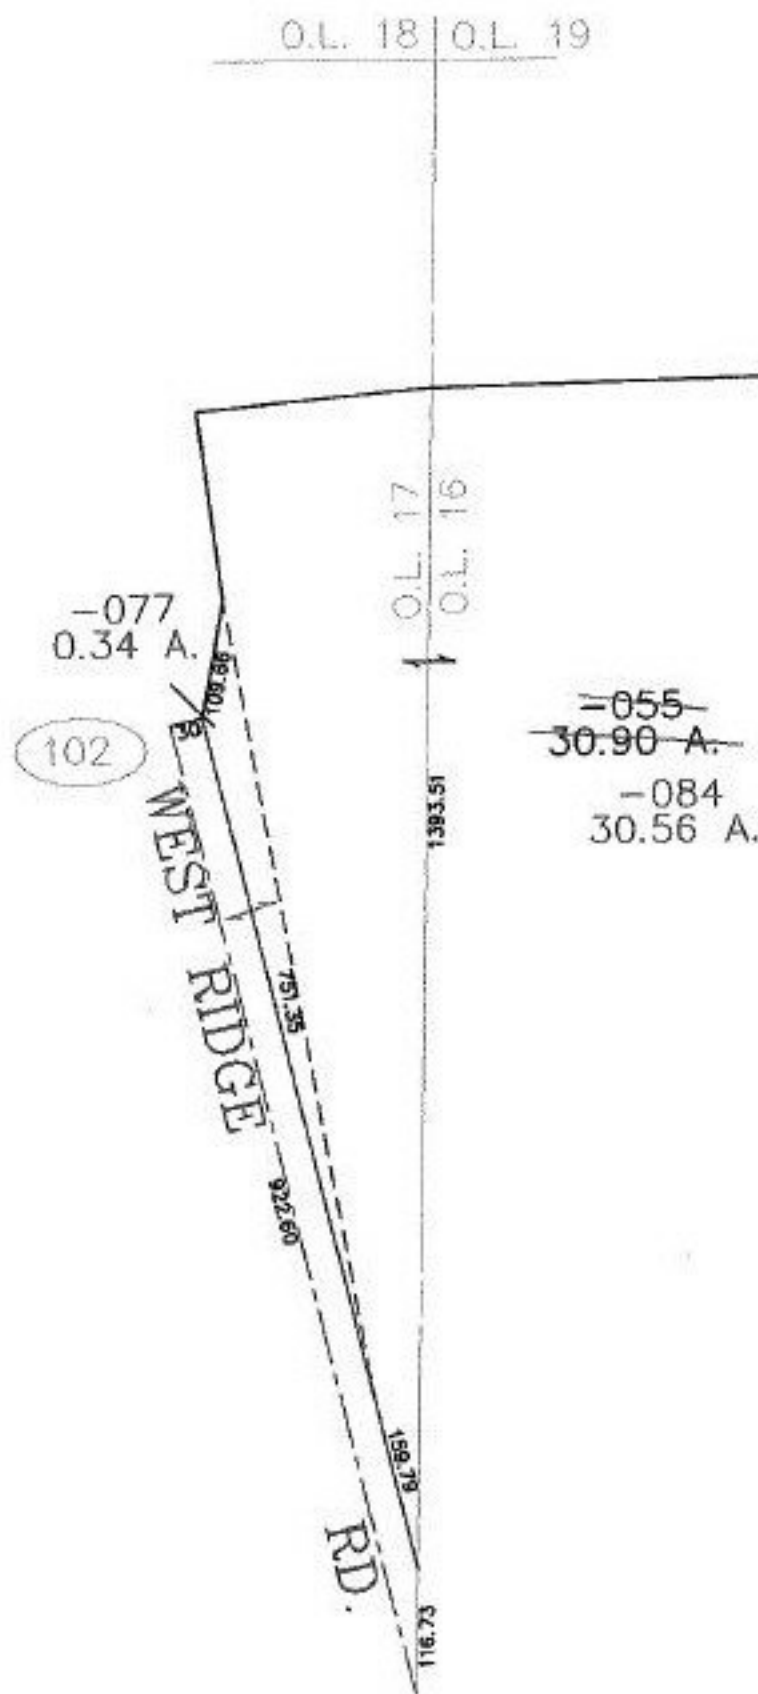

SPLITS/DEEDS PROCESSED
LORAIN COUNTY TAX MAP DEPARTMENT
 226 MIDDLE AVE. ELYRIA, OHIO

SURVEYED BY: JAMES E. KENYON
 CLOSURE: 0.00 : 10.000
 MAP PAGE(S): 6-91
 APPROVED BY: JAH DATE: 1-21-02
 SCALE: 1" = 200' PRIOR INSTRUMENT: DV 742/358