


MASTER

NO. 00971

PARENT PARCEL: 05-00-053-000-007, -008, 020, -027, -028

CHILD PARCEL: 05-00-053-000-068 THRU -076

STARTING POINT: CENTERLINE OF MILAN-ELYRIA RD. & OBERLIN RD.

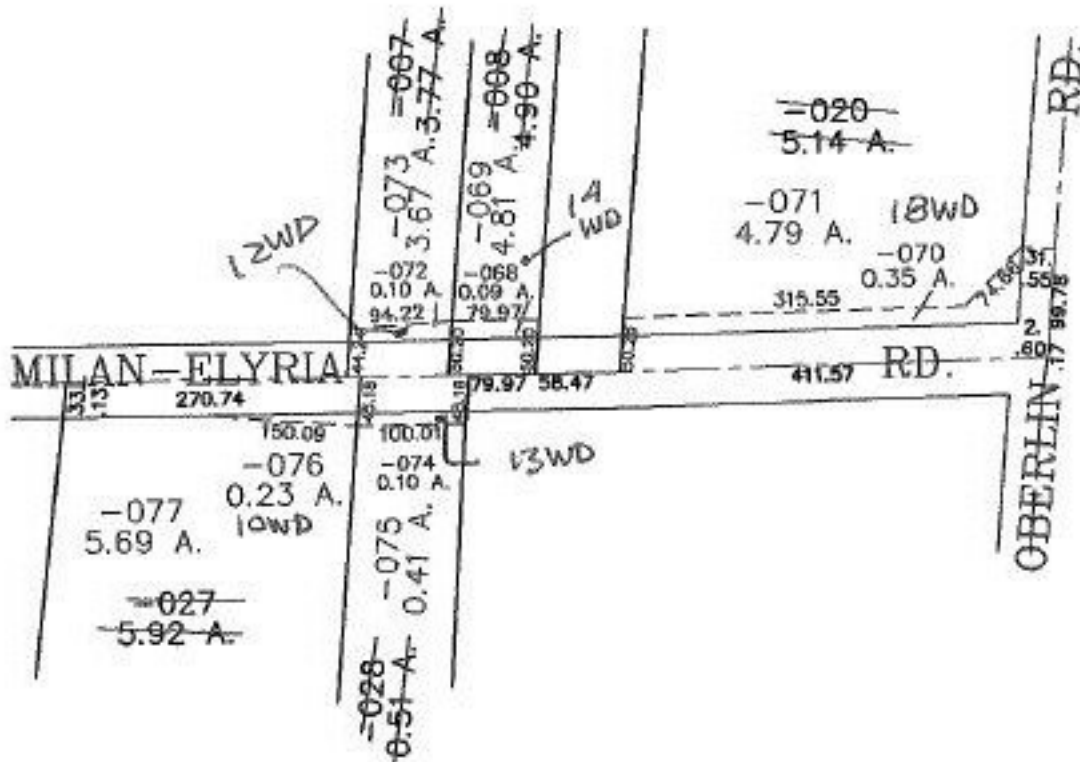

SPLITS/DEEDS PROCESSED
LORAIN COUNTY TAX MAP DEPARTMENT
 226 MIDDLE AVE. ELYRIA, OHIO

SURVEYED BY: JAMES E. KENYON
 CLOSURE: 0.01 : 10.000
 MAP PAGE(S): 5-00-053-B
 APPROVED BY: JAH DATE: 3-12-02
 SCALE: 1" = 200' PRIOR INSTRUMENT: DV 1128/784