
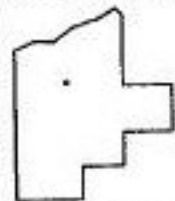


PARENT PARCEL: 05-00-053-000-053, -054

CHILD PARCEL: 05-00-053-000-064 THRU -067

STARTING POINT: CENTERLINE OF OBERLIN RD. & MILAN-ELYRIA RD.

NO. 00972

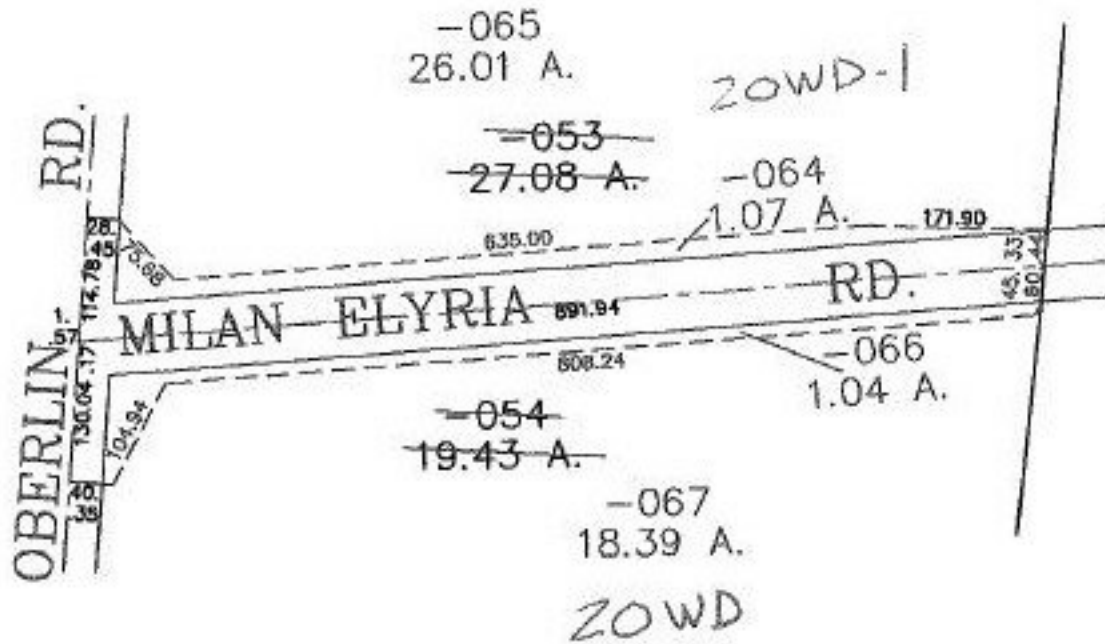

**SPLITS/DEEDS PROCESSED**  
 LORAIN COUNTY TAX MAP DEPARTMENT  
 226 MIDDLE AVE. ELYRIA, OHIO

SURVEYED BY: JAMES E. KENYON  
 CLOSURE: 0.01 : 10,000  
 MAP PAGE(S): 05-00-053-B  
 APPROVED BY: JAH DATE: 3-12-02  
 SCALE: 1" = 200' PRIOR INSTRUMENT: 970501916