


RASTER

PARENT PARCEL: 04-00-002-101-062, -044

CHILD PARCEL: 04-00-002-101-078, -079

STARTING POINT: CENTERLINE OF FRENCH CREEK RD. & MOON RD.

NO. 00973

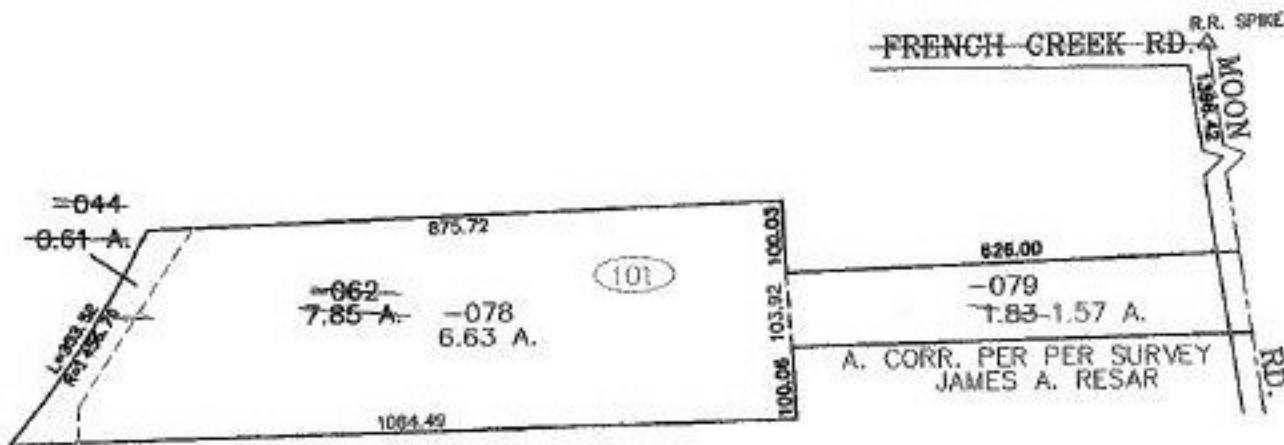

SURVEYED BY: JAMES A. RESAR

CLOSURE: 0.00 : 10.000

MAP PAGE(S): 4-00-002-B

APPROVED BY: JAH DATE: 1-25-02

SCALE: 1" = 300' PRIOR INSTRUMENT: OR 874/358



SPLITS/DEEDS PROCESSED
LORAIN COUNTY TAX MAP DEPARTMENT
226 MIDDLE AVE. ELYRIA, OHIO