

PARENT PARCEL: 01-00-032-000-052

CHILD PARCEL: 01-00-032-000-071 & -072



STARTING POINT: SOUTHWEST CORNER OF SUBLT 43

NO. 00974



S/L  
43

BIG OAKS SUBD. NO 3  
VOL 35 PG 19

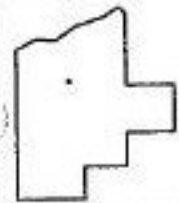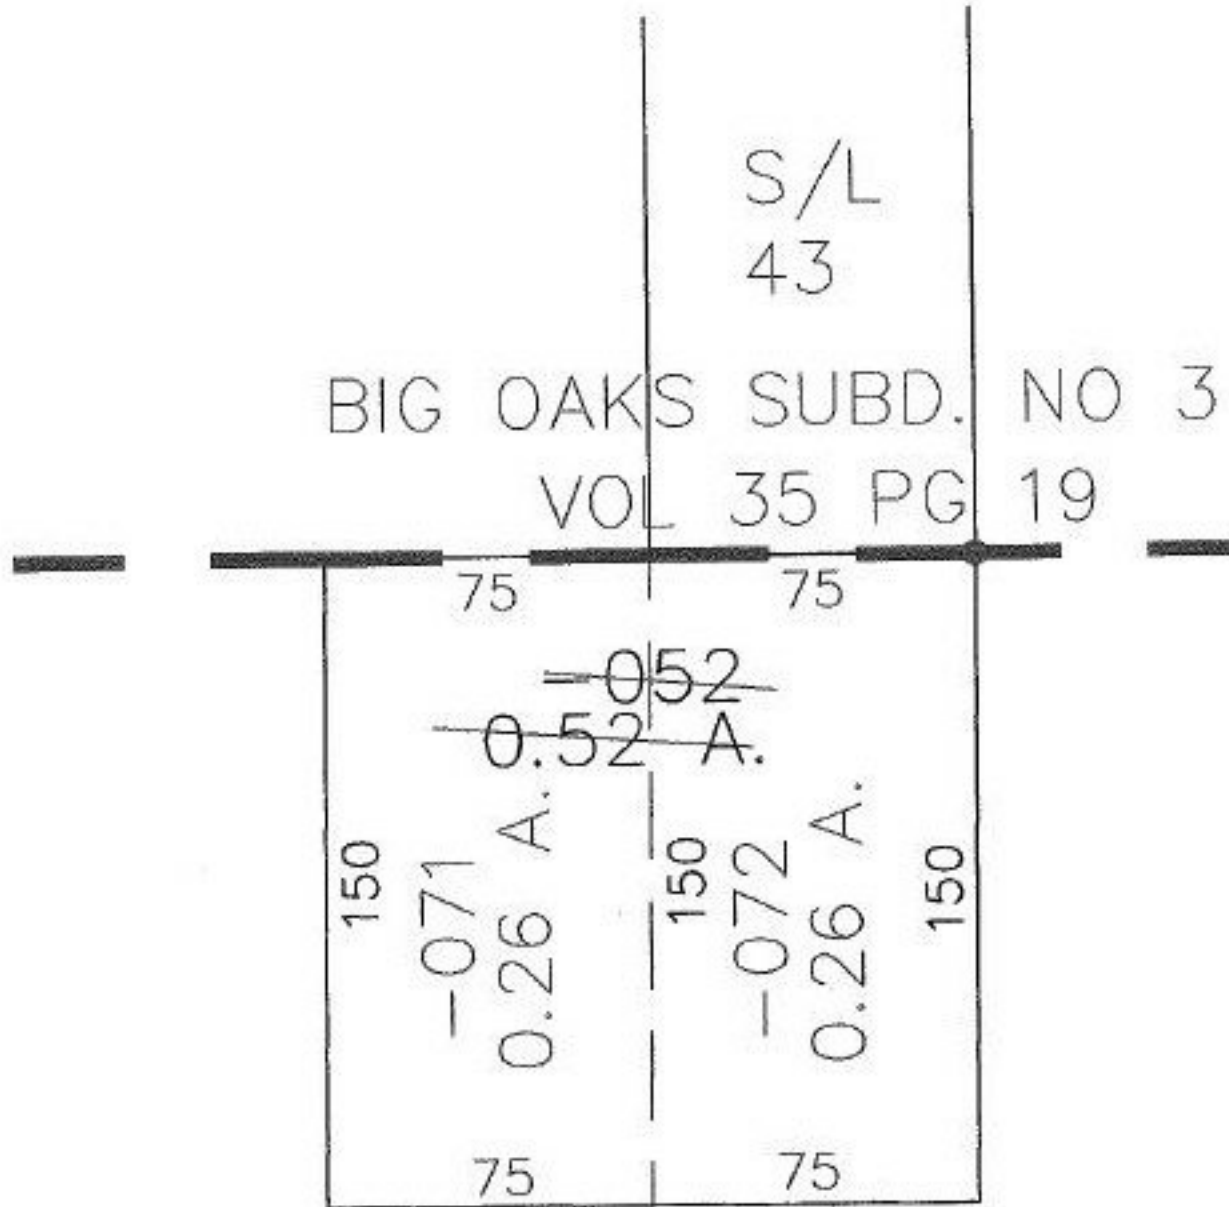

**SPLITS/DEEDS PROCESSED**  
LORAIN COUNTY TAX MAP DEPARTMENT  
226 MIDDLE AVE. ELYRIA, OHIO

SURVEYED BY:	M.G. HURA
CLOSURE:	0.01 : 10.000
MAP PAGE(S):	1-00-032-A
APPROVED BY:	JAH
DATE:	1-29-02
SCALE:	1" = 50'
PRIOR INSTRUMENT:	DV 1408/661