


PARENT PARCEL: 06-24-013-000-006

CHILD PARCEL: 06-24-013-000-008, -009

STARTING POINT: SOUTHEAST CORNER OF O.L. 13

NO. 00980

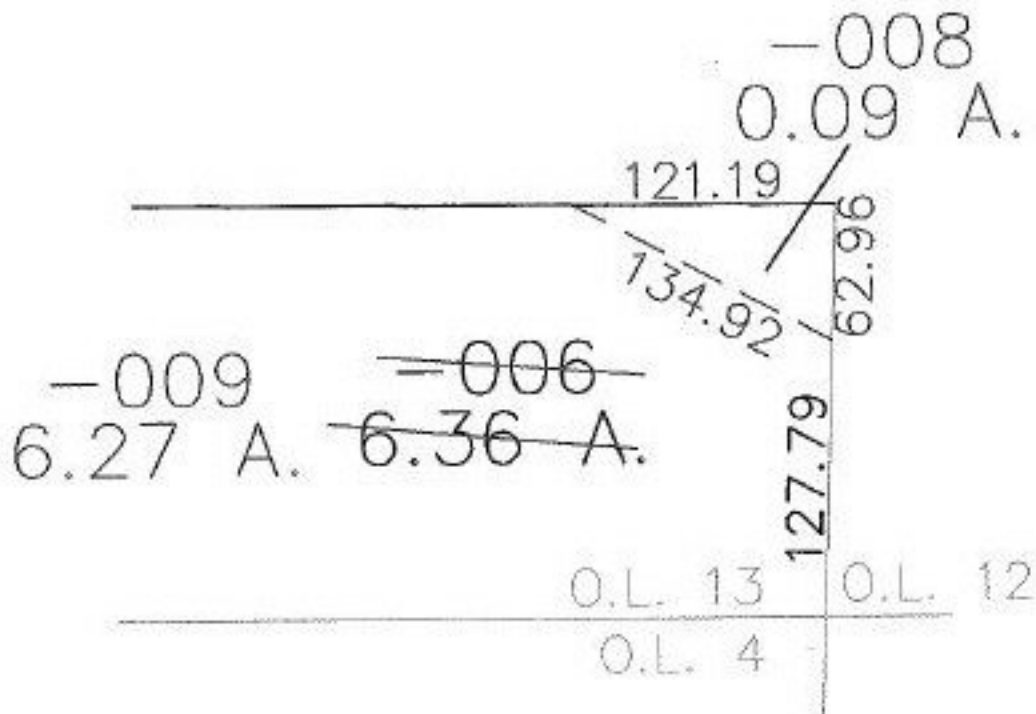

SPLITS/DEEDS PROCESSED

LORAIN COUNTY TAX MAP DEPARTMENT
226 MIDDLE AVE. ELYRIA, OHIO

SURVEYED BY: MARK YEAGER

CLOSURE: 0.00 : 10.000

MAP PAGE(S): 6-113

APPROVED BY: JAH DATE: 2-21-02

SCALE: 1" = 100 PRIOR INSTRUMENT: 980549285