
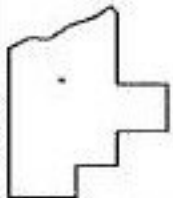


PARENT PARCEL: 11-00-090-000-004

CHILD PARCEL: 11-00-090-000-039, -040

STARTING POINT: CENTERLINE OF CHESTNUT RIDGE RD. & DURKEE RD.

NO. 00982

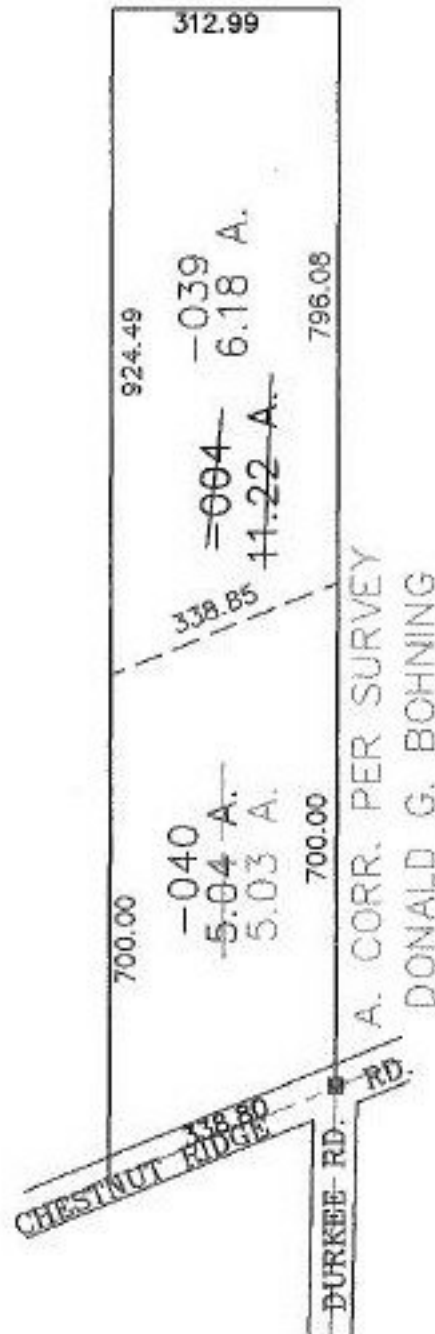

SPLITS/DEEDS PROCESSED
LORAIN COUNTY TAX MAP DEPARTMENT
 226 MIDDLE AVE. ELYRIA, OHIO

SURVEYED BY: DONALD G. BOHNING
 CLOSURE: 0.00 : 10.000
 MAP PAGE(S): 11-A
 APPROVED BY: JAH DATE: 2-7-02
 SCALE: 1" = 300' PRIOR INSTRUMENT: DV 1093/736