


MASTER

PARENT PARCEL: 11-00-071-000-098

CHILD PARCEL: 11-00-071-000-101, -102

STARTING POINT: CENTERLINE OF CHESTNUT RIDGE RD. & O.L. 71

NO. 00984

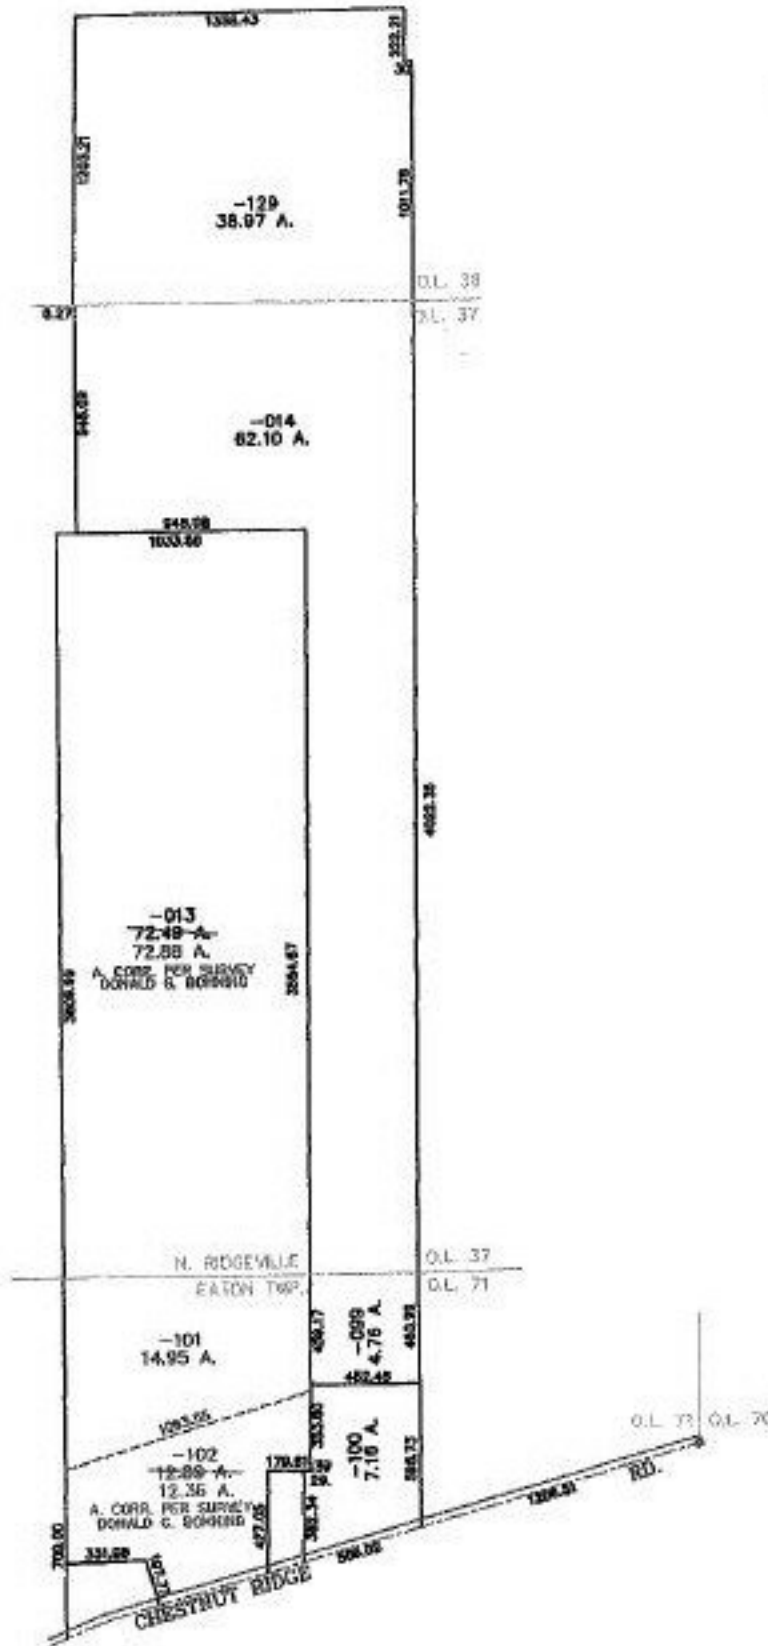

**SPLITS/DEEDS PROCESSED**

LORAIN COUNTY TAX MAP DEPARTMENT  
226 MIDDLE AVE. ELYRIA, OHIO

SURVEYED BY: DONALD G. BOHNING

CLOSURE: 0.00 : 10.000

MAP PAGE(S): 11-00-071-A

APPROVED BY: JAH DATE: 2-8-02

SCALE: 1" = 900 PRIOR INSTRUMENT: 2000696249