
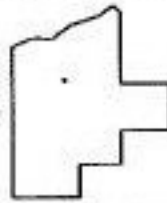


MASTER

PARENT PARCEL: 07-00-030-000-003, -036, -057
CHILD PARCEL: 07-00-030-000-075 THRU -081
STARTING POINT: CENTERLINE OF MILLS RD. & WOOSTER-AVON LAKE RD.

NO. 00990

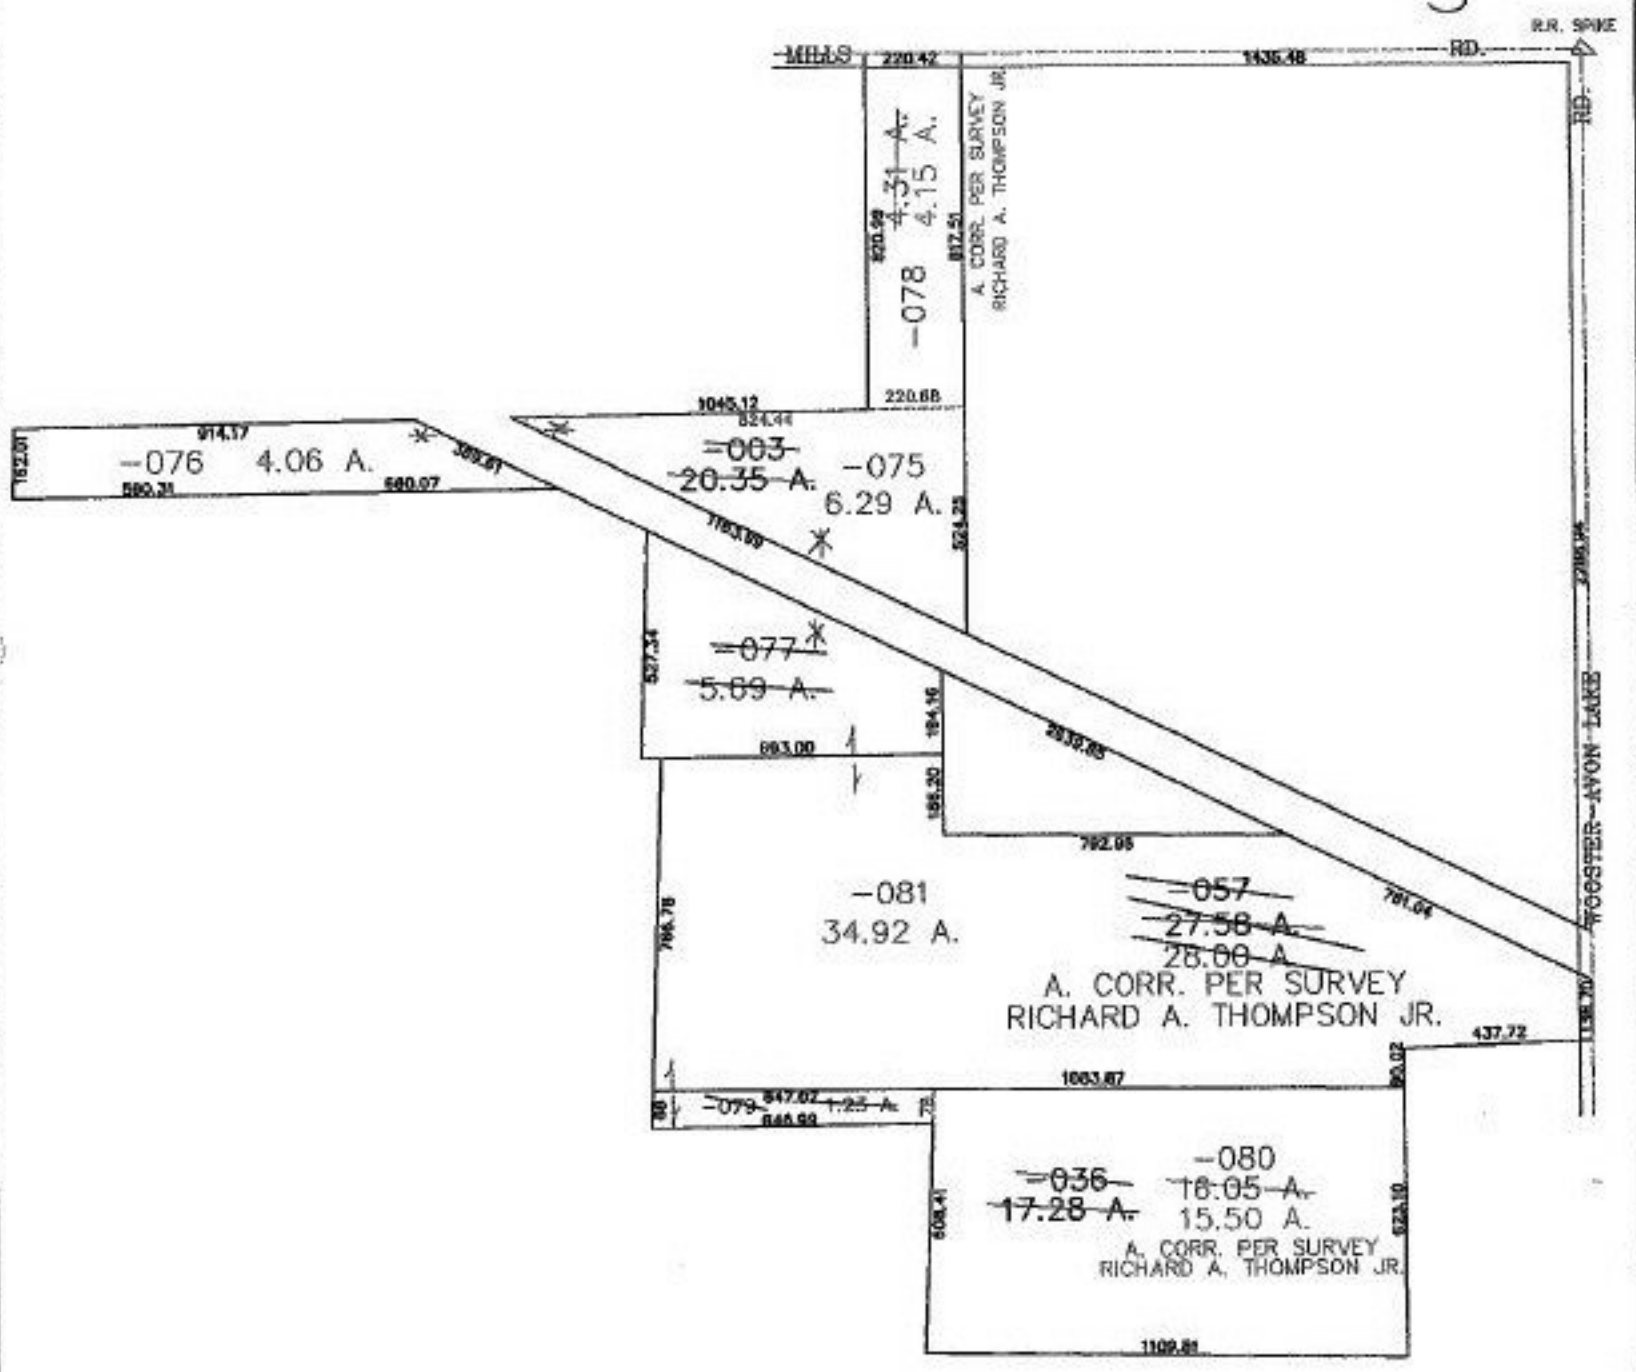

SPLITS/DEEDS PROCESSED

LORAIN COUNTY TAX MAP DEPARTMENT
228 MIDDLE AVE. ELYRIA, OHIO

SURVEYED BY: RICHARD A. THOMPSON JR.
CLOSURE: 0.00 : 10.000
MAP PAGE(S): 7-8
APPROVED BY: JAH DATE: 2-21-02
SCALE: 1" = 100' PRIOR INSTRUMENT: DV 1426/277