


RASTER

PARENT PARCEL: 03-00-001-000-105

CHILD PARCEL: 03-00-001-000-123 THRU -125


STARTING POINT: CENTERLINE OF NORTH ABBE RD. & NORTH RIDGE RD.

NO. 00995

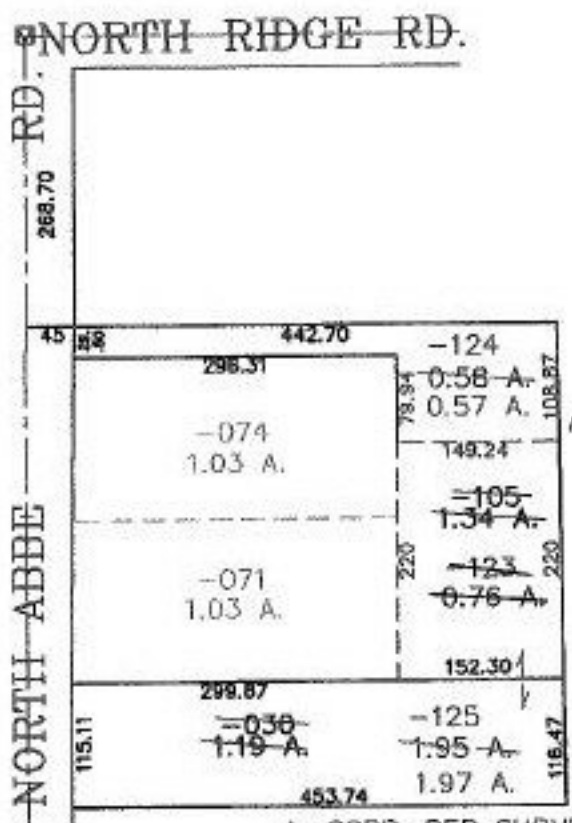

A. CORR. PER SURVEY
DAVID L. ELWELL

A. CORR. PER SURVEY
DAVID L. ELWELL

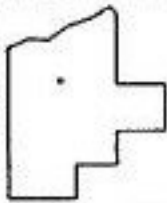

SPLITS/DEEDS PROCESSED
LORAIN COUNTY TAX MAP DEPARTMENT
226 MIDDLE AVE. ELYRIA, OHIO

SURVEYED BY: DAVID L. ELWELL
CLOSURE: 0.01 : 10.000
MAP PAGE(S): 3-00-001-A
APPROVED BY: JAH DATE: 3-5-02
SCALE: 1" = 200' PRIOR INSTRUMENT: OR 1202/422