
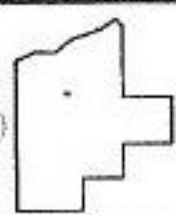


PARENT PARCEL: SEE BELOW  
CHILD PARCEL: 07-00-038-000-134, 07-00-037-000-014, 11-00-071-000-103  
STARTING POINT: CENTERLINE OF CHESTNUT RIDGE RD. & O.L. 71

NO. 00996

- 07-00-036-000-002
- 07-00-038-000-130
- 07-00-038-000-132
- 07-00-038-000-129
- 07-00-037-000-014
- 11-00-071-000-099
- 11-00-071-000-018

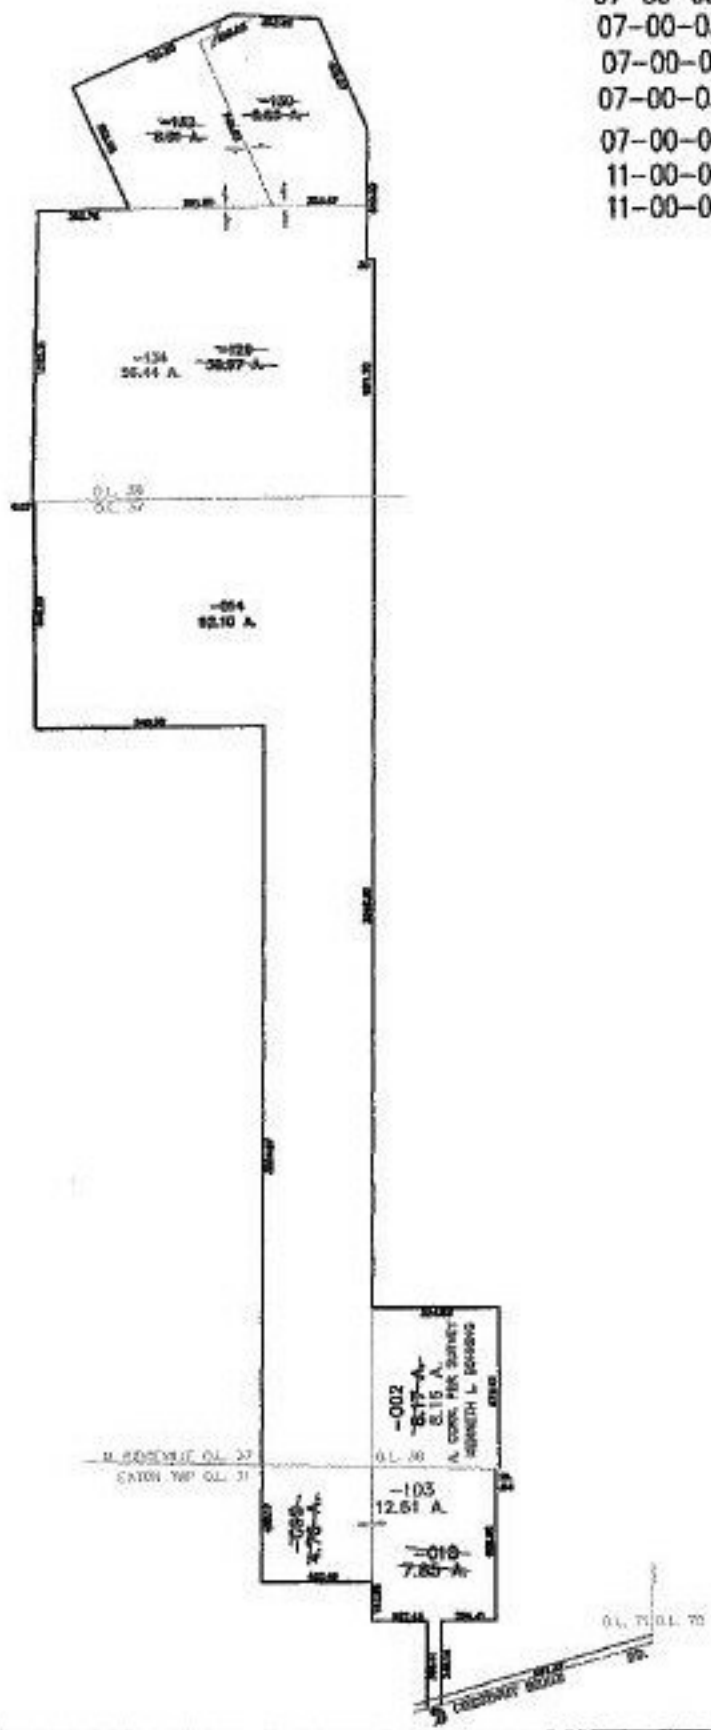

**SPLITS/DEEDS PROCESSED**  
**LORAIN COUNTY TAX MAP DEPARTMENT**  
 226 MIDDLE AVE. ELYRIA, OHIO

SURVEYED BY: DONALD G. BOHNING  
 CLOSURE: 0.00 : 10.000  
 MAP PAGE(S): 11-00-071-A  
 APPROVED BY: JAH DATE: 3-1-02  
 SCALE: 1" = 900 PRIOR INSTRUMENT: 2000696249