


PARENT PARCEL: 04-00-030-141-048, -010, -009, -034  
CHILD PARCEL: 04-00-030-141-182 THRU -184  
STARTING POINT: CENTERLINE OF WALKER RD. & LEAR NAGLE RD.

NO. 00998

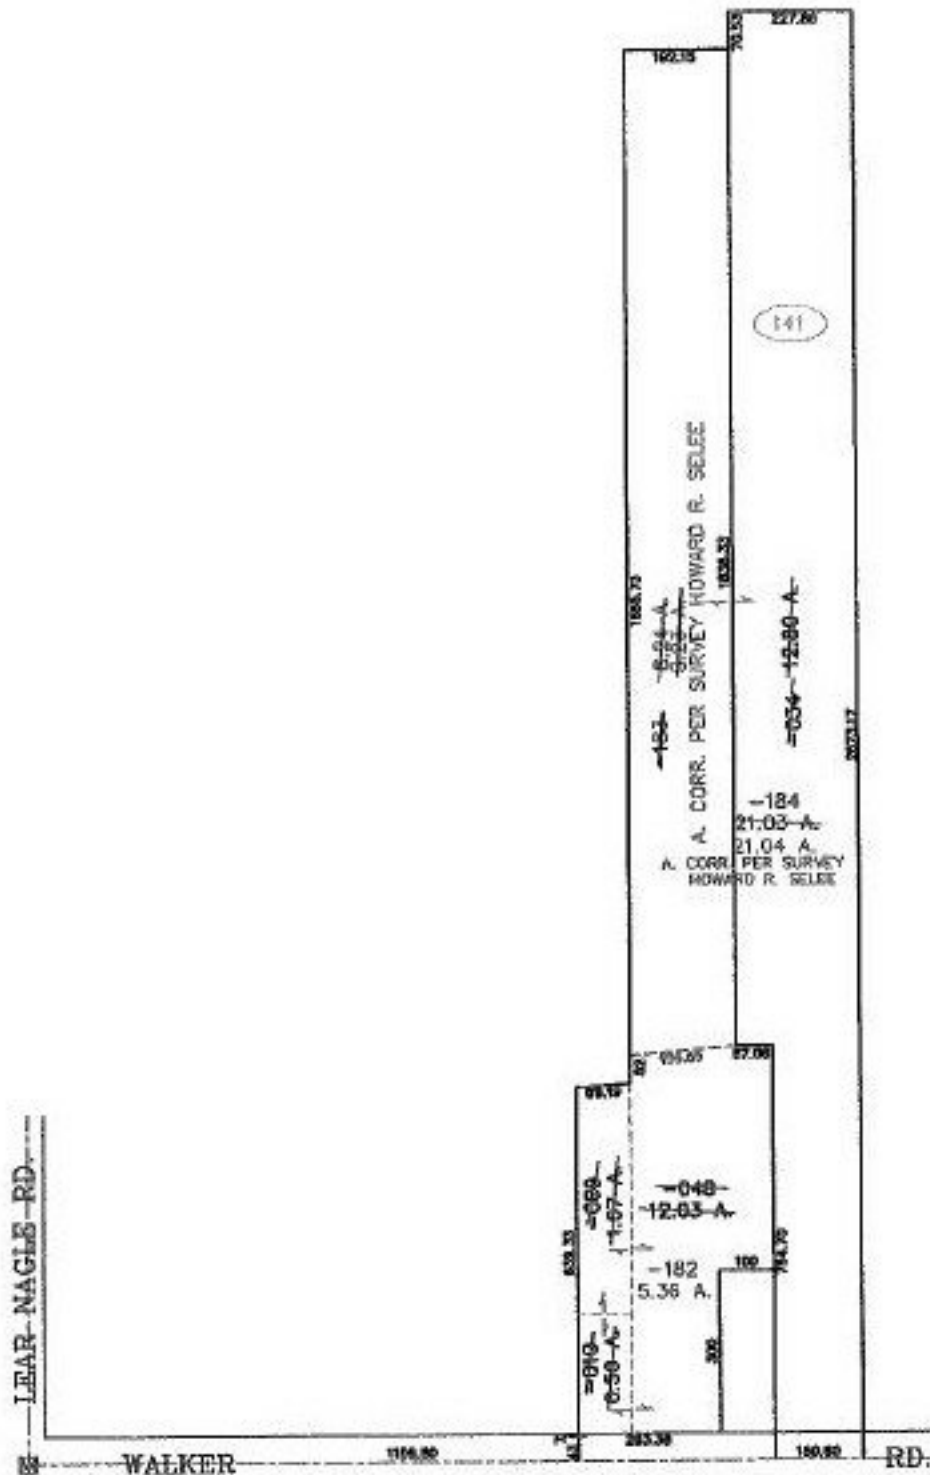

**SPLITS/DEEDS PROCESSED**  
LORAIN COUNTY TAX MAP DEPARTMENT  
226 MIDDLE AVE. ELYRIA, OHIO

SURVEYED BY: HOWARD R. SELEE  
CLOSURE: 0.01 : 10.000  
MAP PAGE(S): 4-00-030-F  
APPROVED BY: JAH DATE: 3-5-02  
SCALE: 1" = 400 PRIOR INSTRUMENT: 980568812