
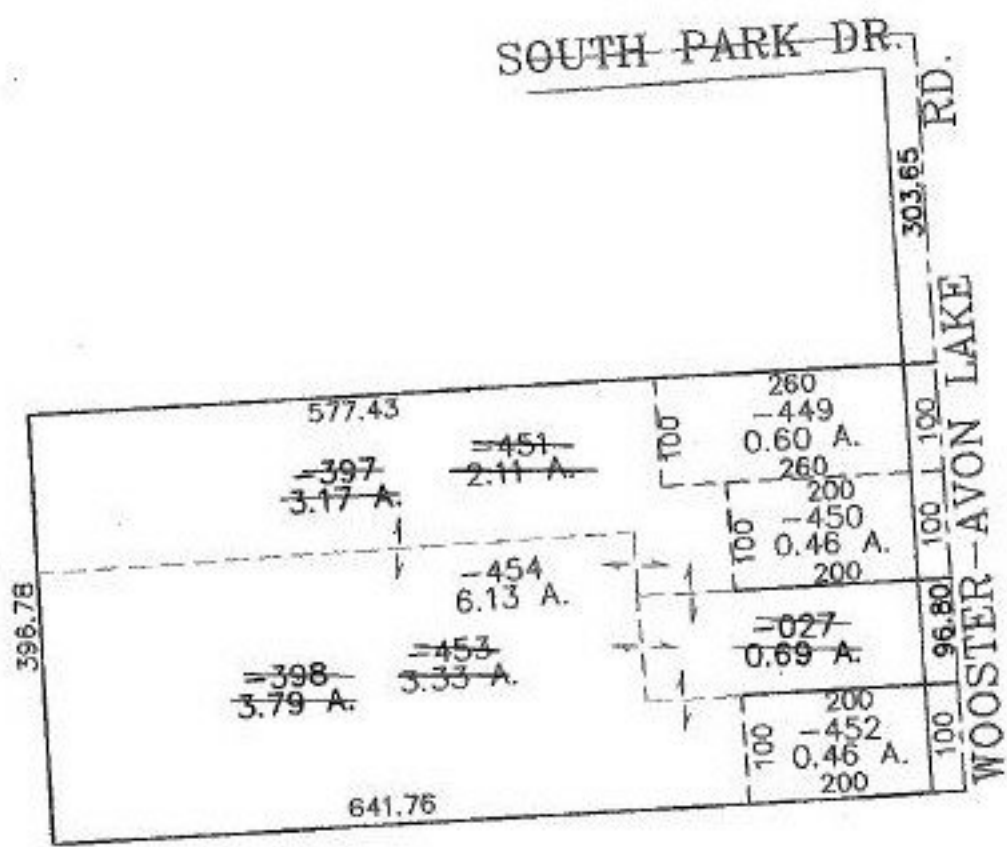


PARENT PARCEL: 04-00-013-000-027, -397, -398
CHILD PARCEL: 04-00-013-000-449 THRU -454
STARTING POINT: CENTERLINE OF WOOSTER-AVON LAKE RD. & SOUTH PARK DR.

NO. 01000

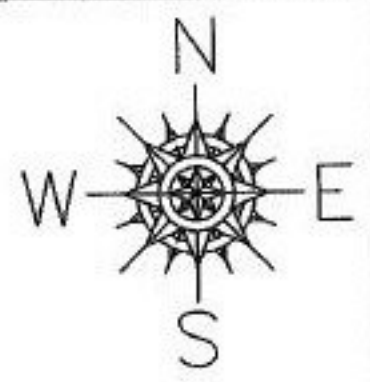

SPLITS/DEEDS PROCESSED
LORAIN COUNTY TAX MAP DEPARTMENT
226 MIDDLE AVE. ELYRIA, OHIO

SURVEYED BY: RICHARD A. THOMPSON JR.
CLOSURE: 0.00 : 10.000
MAP PAGE(S): 4-00-013-B
APPROVED BY: JAH DATE: 3-6-02
SCALE: 1" = 200' PRIOR INSTRUMENT: OR 1348/925