


RASTER

NO. 01003

PARENT PARCEL: 06-23-010-101-004, -042

CHILD PARCEL: 06-23-010-101-044 THRU -049

STARTING POINT: MONUMENT BOX IN THE CENTERLINE OF LAKE AVE. & PC STA 73 + 41.00

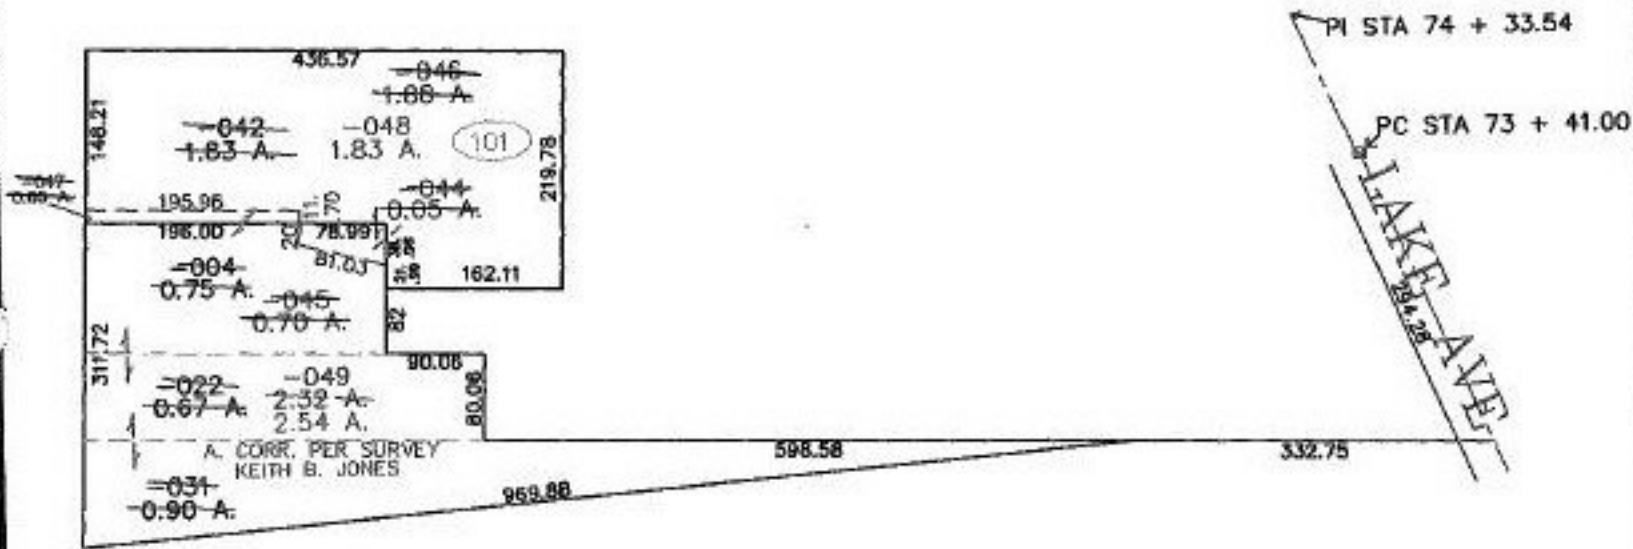

103



SPLITS/DEEDS PROCESSED
LORAIN COUNTY TAX MAP DEPARTMENT
 226 MIDDLE AVE. ELYRIA, OHIO

SURVEYED BY: KEITH B. JONES
 CLOSURE: 0.00 ; 10.000
 MAP PAGE(S): 6-24
 APPROVED BY: JAH DATE: 3-14-02
 SCALE: 1" = 200 PRIOR INSTRUMENT: DV 1267/827