


RASTER

PARENT PARCEL: 14-00-056-000-015


CHILD PARCEL: 14-00-056-000-017 THRU -020

STARTING POINT: CENTERLINE OF HUGHES RD. & HALLAUER RD.

NO. 01005

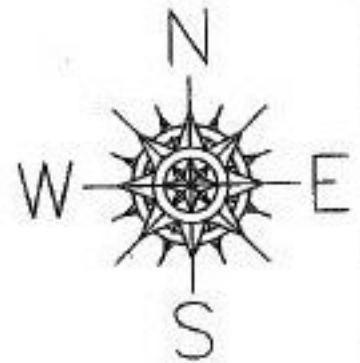

HUGHES RD.

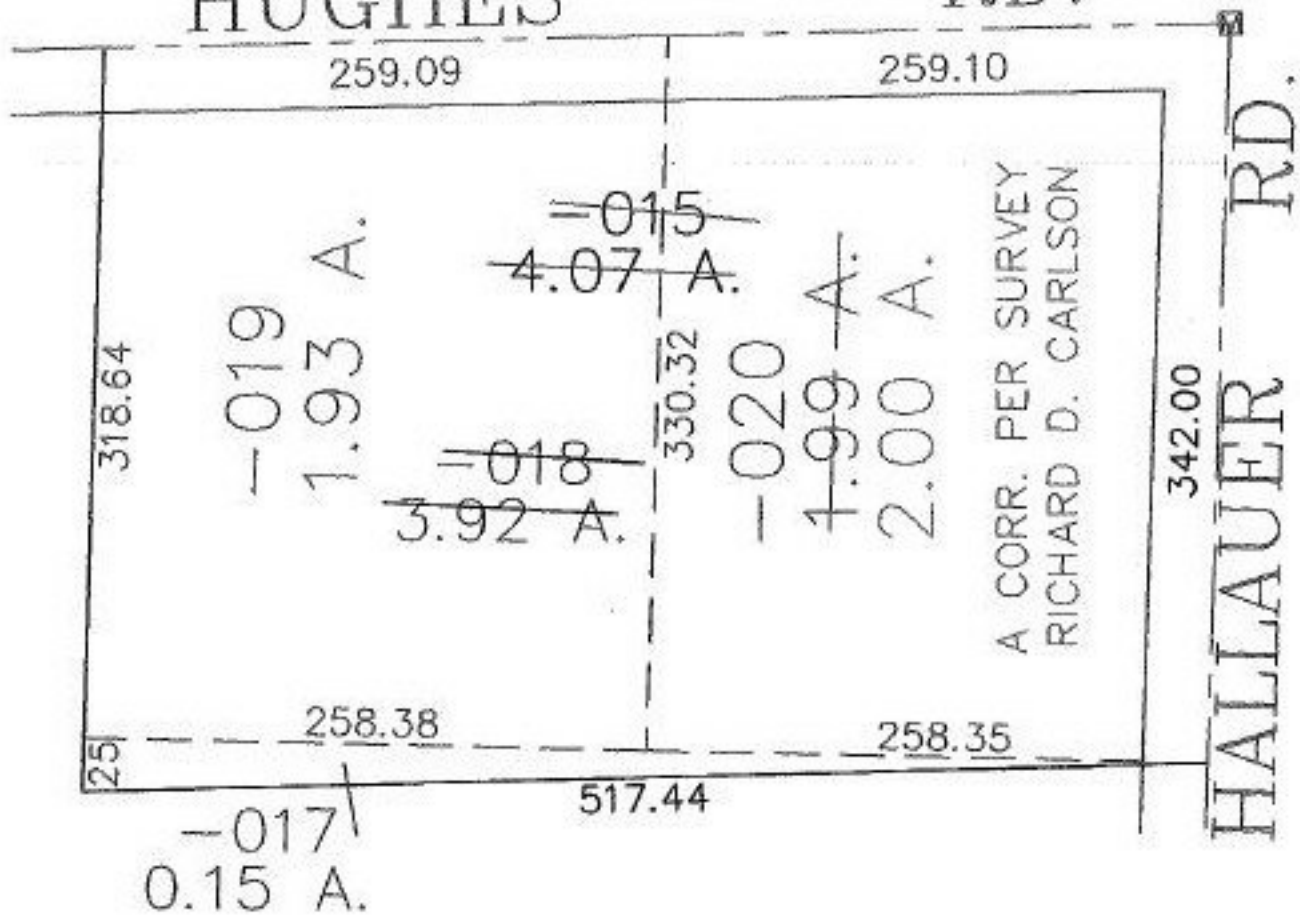

0.15 A.



SPLITS/DEEDS PROCESSED

LORAIN COUNTY TAX MAP DEPARTMENT
226 MIDDLE AVE. ELYRIA, OHIO

SURVEYED BY: RICHARD D. CARLSON

CLOSURE: 0.00 : 10.000

MAP PAGE(S): 14-C

APPROVED BY: JAH DATE: 3-12-02

SCALE: 1" = 100' PRIOR INSTRUMENT: 990643528