


PARENT PARCEL: 01-00-076-000-072, -004, -005
CHILD PARCEL: 01-00-076-000-076 THRU -078
STARTING POINT: CENTERLINE OF VERMILION RD. & PORTMAN RD.

NO. 01015

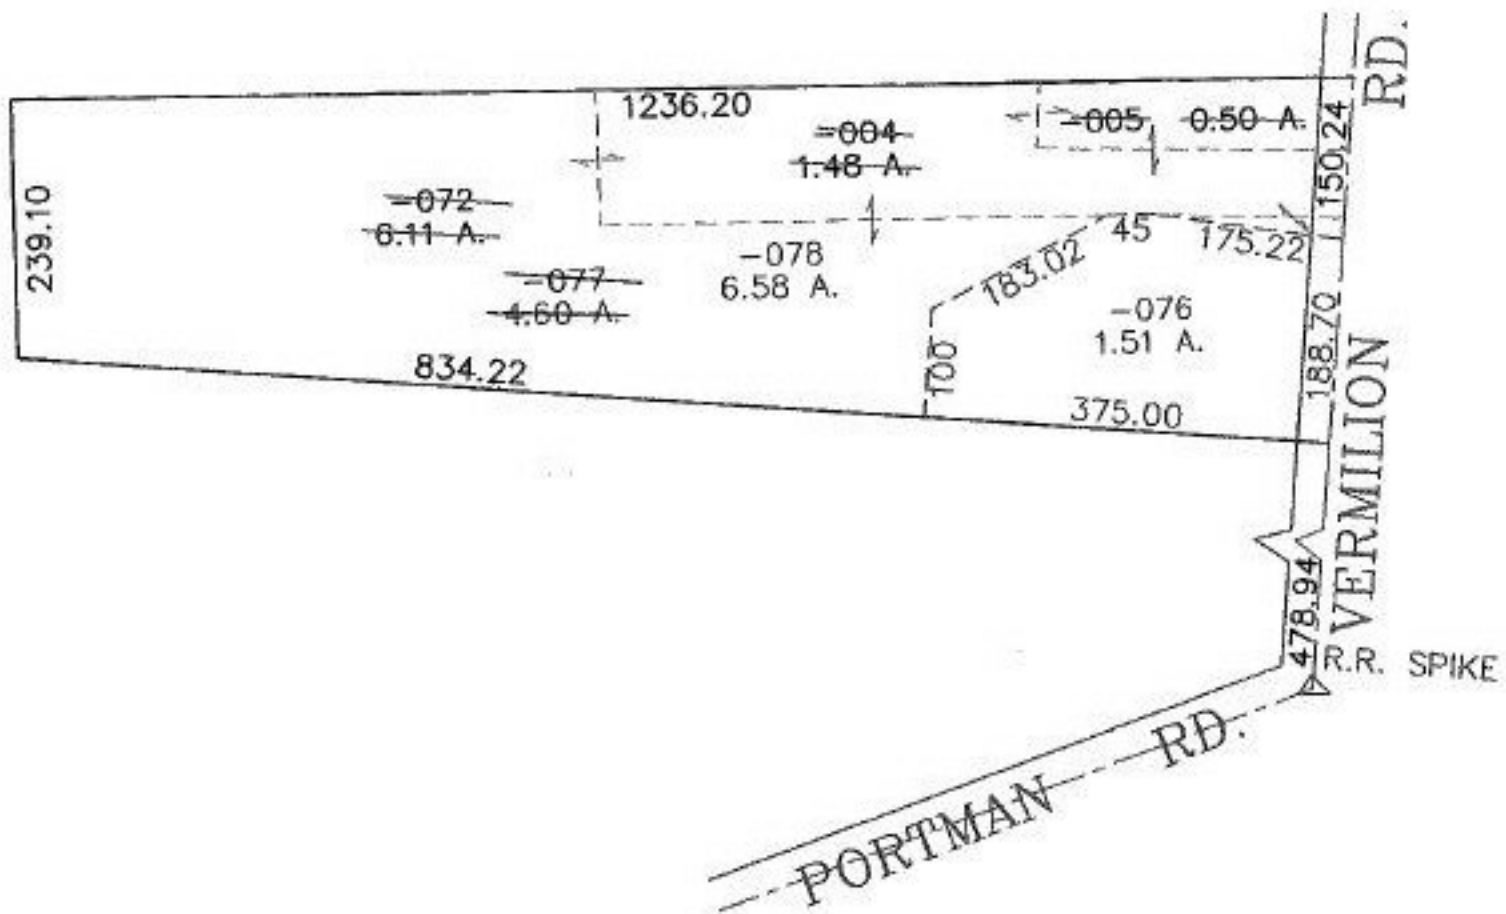

SPLITS/DEEDS PROCESSED
LORAIN COUNTY TAX MAP DEPARTMENT
226 MIDDLE AVE. ELYRIA, OHIO

SURVEYED BY: EARL HUNTER
CLOSURE: 0.01 : 10.000
MAP PAGE(S): 1-K
APPROVED BY: JAH DATE: 3-28-02
SCALE: 1" = 200' PRIOR INSTRUMENT: 980563148