


PARENT PARCEL: 05-00-094-105-005 THRU -008
CHILD PARCEL: 05-00-094-105-035 THRU -046
STARTING POINT: CENTERLINE OF QUARRY RD. & O.L. 94

NO. 01019

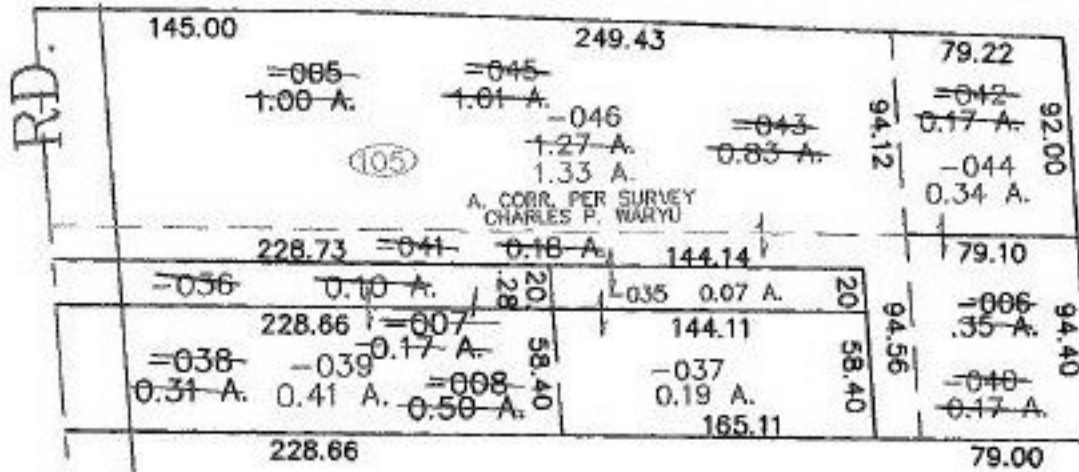

SPLITS/DEEDS PROCESSED

LORAIN COUNTY TAX MAP DEPARTMENT
226 MIDDLE AVE. ELYRIA, OHIO

SURVEYED BY: CHARLES P. WARYU
CLOSURE: 0.00 : 10.000
MAP PAGE(S): 5-00-094-C
APPROVED BY: JAH DATE: 4-9-02
SCALE: 1" = 100 PRIOR INSTRUMENT: OR 707/569