


RASTER

PARENT PARCEL: 05-00-035-105-002, -003
CHILD PARCEL: 05-00-035-105-017 THRU -022
STARTING POINT: CENTERLINE OF LEAVITT RD. & O.L. 35

NO. 01028

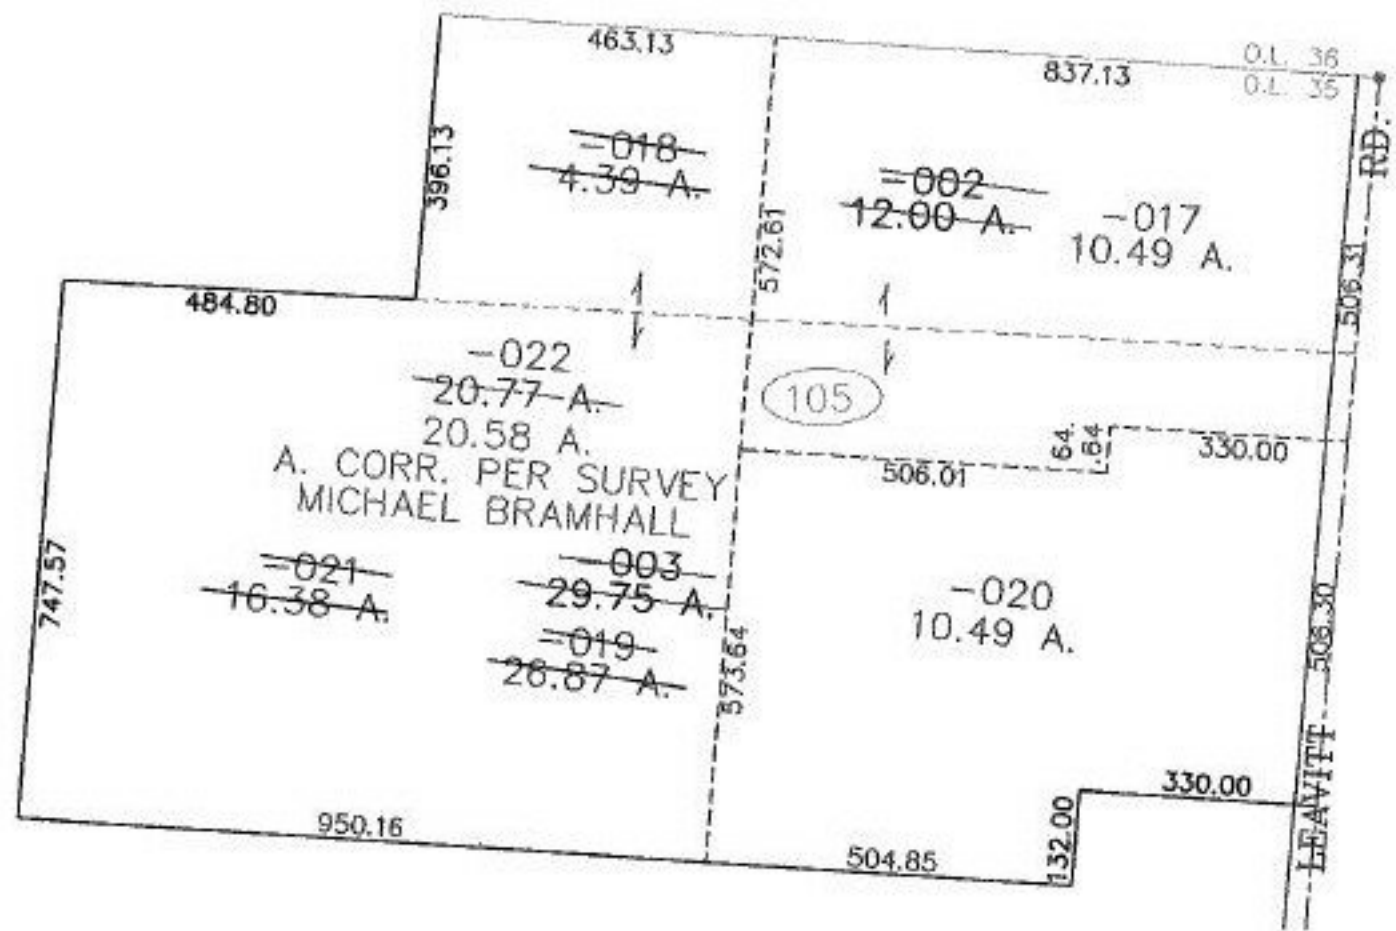

SPLITS/DEEDS PROCESSED
LORAIN COUNTY TAX MAP DEPARTMENT
226 MIDDLE AVE. ELYRIA, OHIO

SURVEYED BY: MICHAEL BRAMHALL
CLOSURE: 0.00 : 10.000
MAP PAGE(S): 5-00-035-B
APPROVED BY: JAH DATE: 4-2-02
SCALE: 1" = 300' PRIOR INSTRUMENT: DV 1418/648