
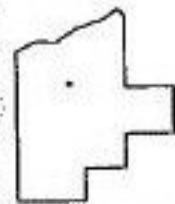
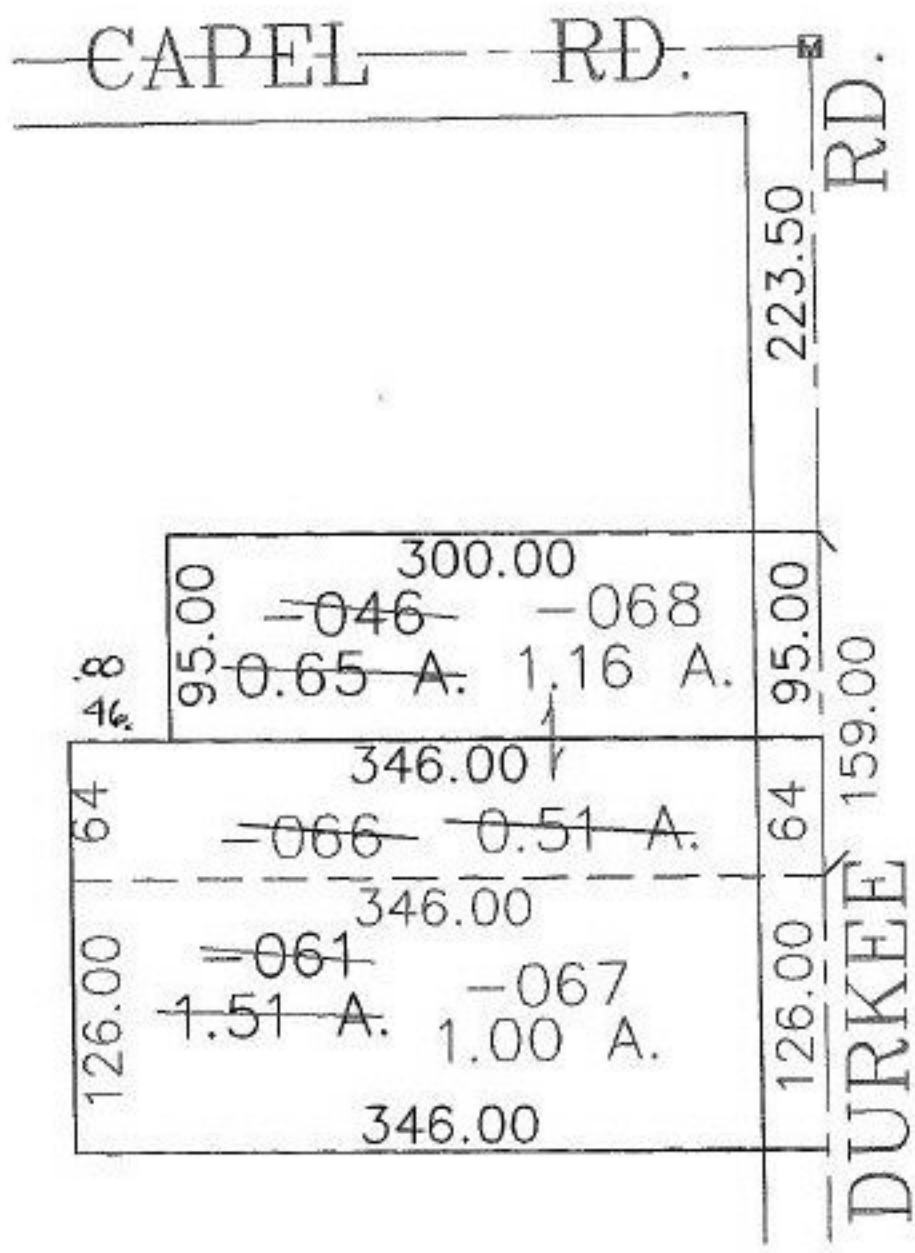


PARENT PARCEL: 11-00-084-000-061, -046
CHILD PARCEL: 11-00-084-000-066 THRU -068
STARTING POINT: CENTERLINE OF DURKEE RD. & CAPEL RD.

NO. 01032

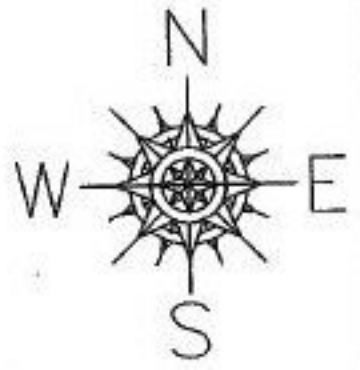

SPLITS/DEEDS PROCESSED

LORAIN COUNTY TAX MAP DEPARTMENT
226 MIDDLE AVE. ELYRIA, OHIO

SURVEYED BY: JOHN POZYWAK
CLOSURE: 0.00 : 10.000
MAP PAGE(S): 11-00-084
APPROVED BY: JAH DATE: 4-3-02
SCALE: 1" = 100' PRIOR INSTRUMENT: 20020818106