


RASTER

PARENT PARCEL: 03-00-001-000-018, 03-00-002-102-020
CHILD PARCEL: 03-00-002-102-044, 03-00-001-000-126 THRU -128
STARTING POINT: CENTERLINE OF DETROIT RD. & ABBE RD.

NO. 01033

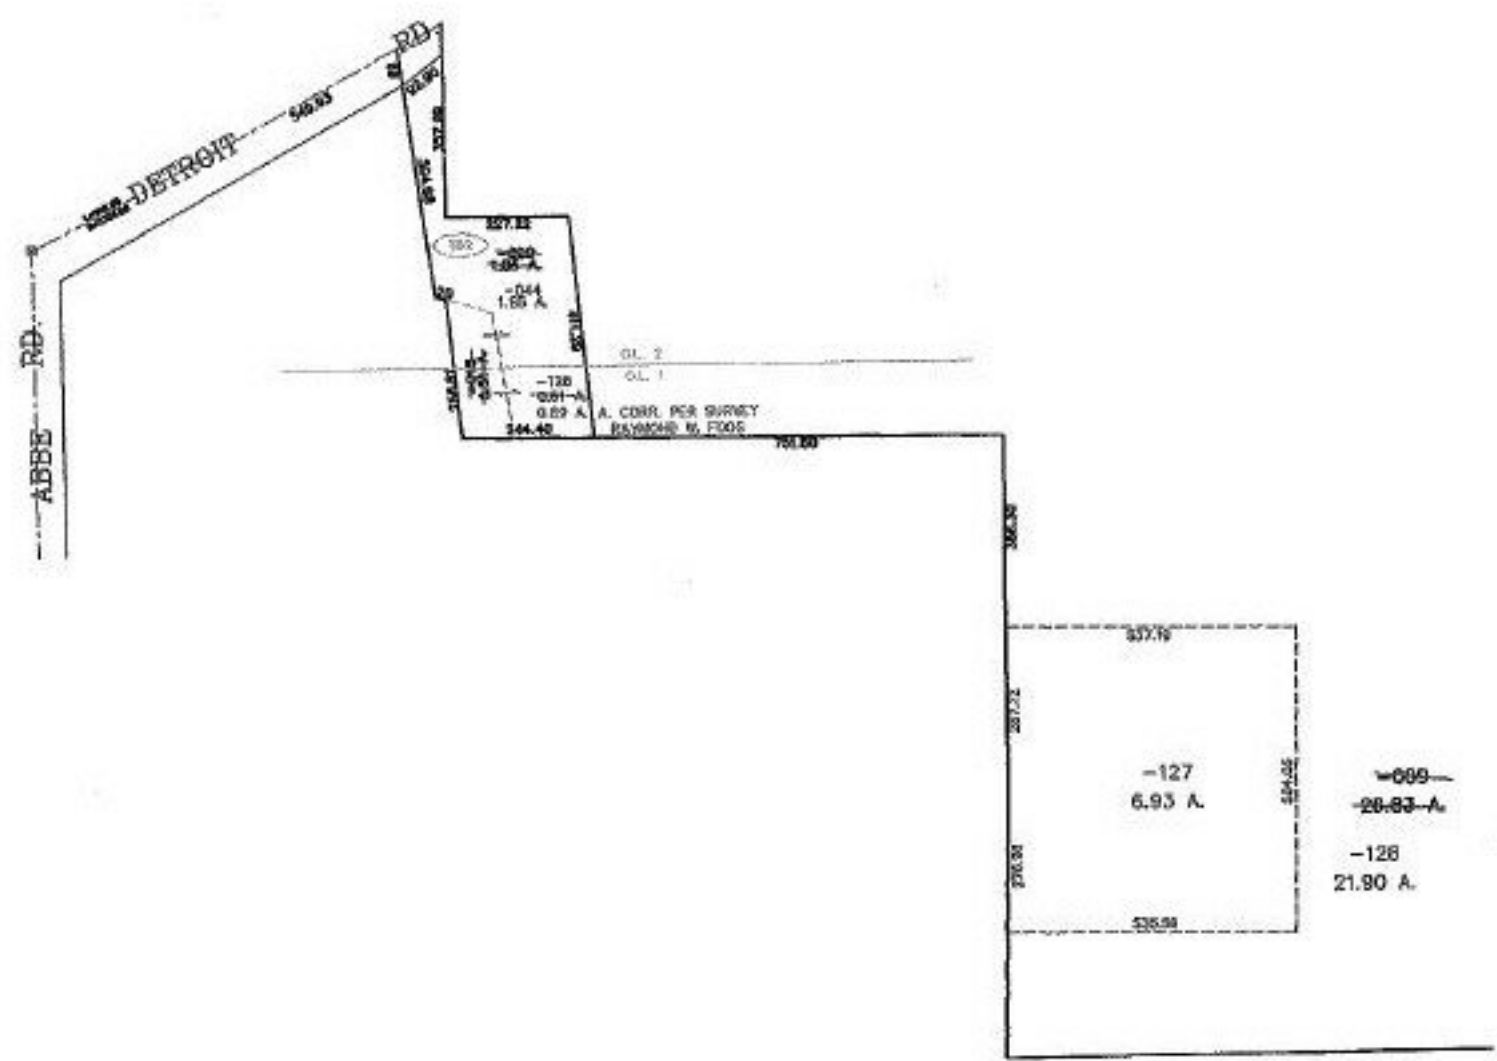

SPLITS/DEEDS PROCESSED
LORAIN COUNTY TAX MAP DEPARTMENT
226 MIDDLE AVE. ELYRIA, OHIO

SURVEYED BY: RAYMOND W. FOOS
CLOSURE: 0.00 : 10.000
MAP PAGE(S): 3-00-001-A -002-A
APPROVED BY: JAH DATE: 4-12-02
SCALE: 1" = 400 PRIOR INSTRUMENT: OR 1438/745