


PARENT PARCEL: 04-00-011-108-140  
CHILD PARCEL: 04-00-011-108-141 THRU -143  
STARTING POINT: WESTERLY LINE OF HIGHLAND PARK SUBD. NO. 9

NO. 01038

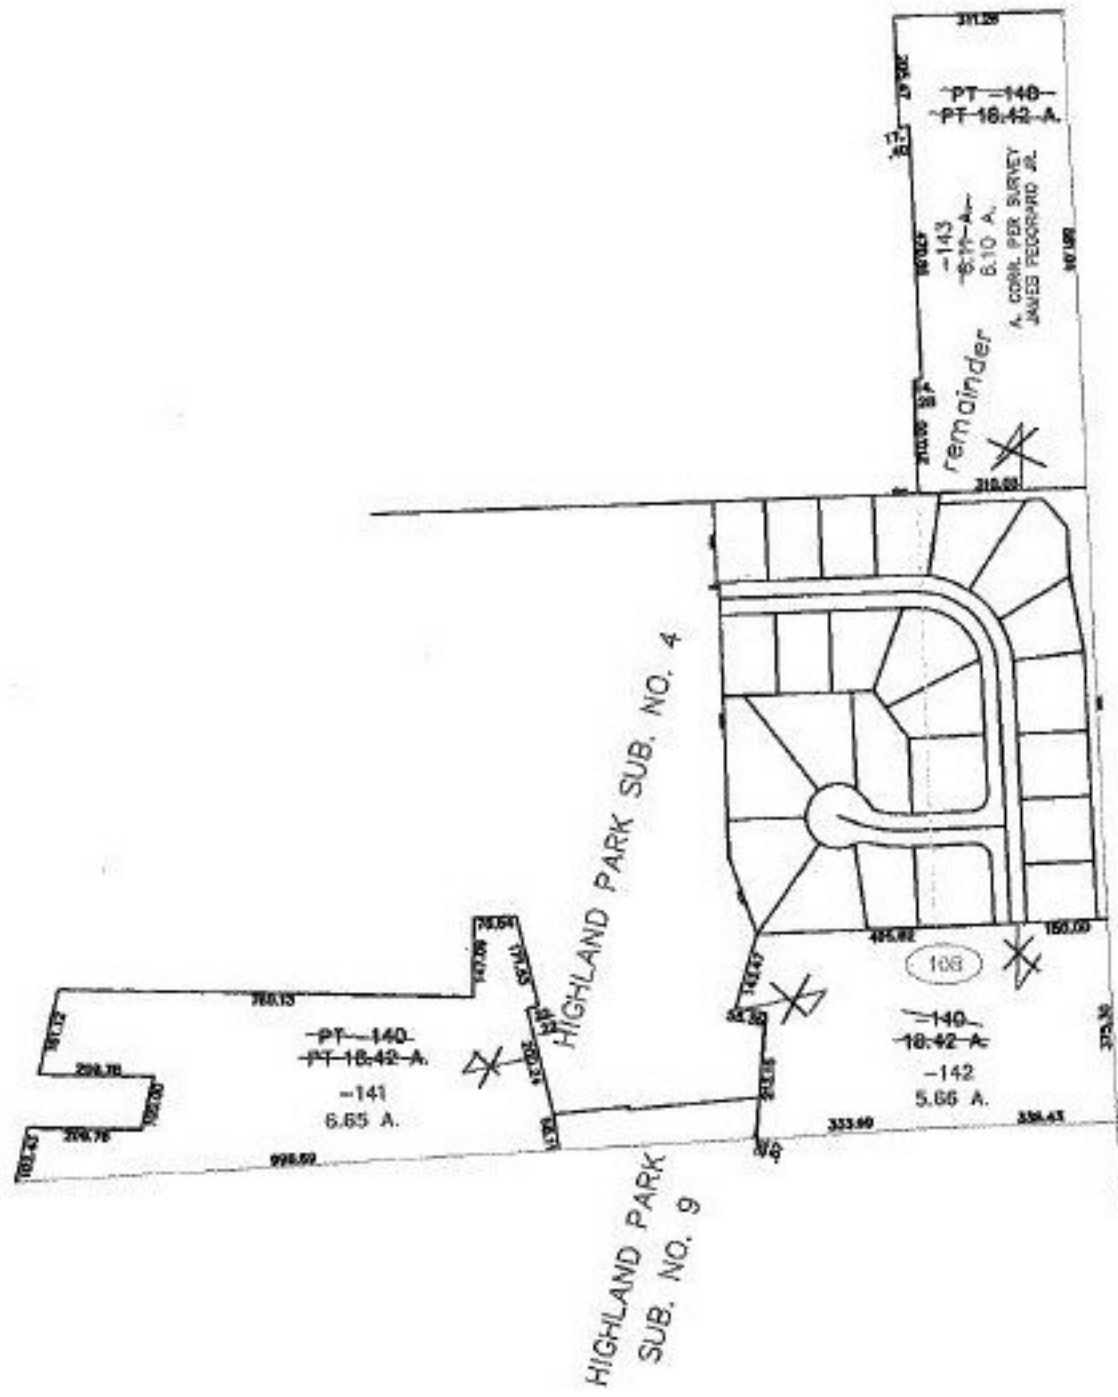

**SPLITS/DEEDS PROCESSED**  
LORAIN COUNTY TAX MAP DEPARTMENT  
226 MIDDLE AVE. ELYRIA, OHIO

SURVEYED BY: JAMES PEGORARO JR.  
CLOSURE: 0.02 : 10.000  
MAP PAGE(S): 4-00-011-H  
APPROVED BY: JAH DATE: 4-10-02  
SCALE: 1" = 400' PRIOR INSTRUMENT: OR 1045/603