
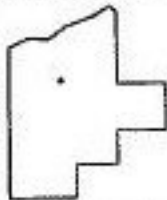


PARENT PARCEL: 01-00-040-000-017, -010

CHILD PARCEL: 01-00-040-000-018, -019, -020

STARTING POINT: CENTERLINE OF NORTH RIDGE RD. & O.L. 40

NO. 01043

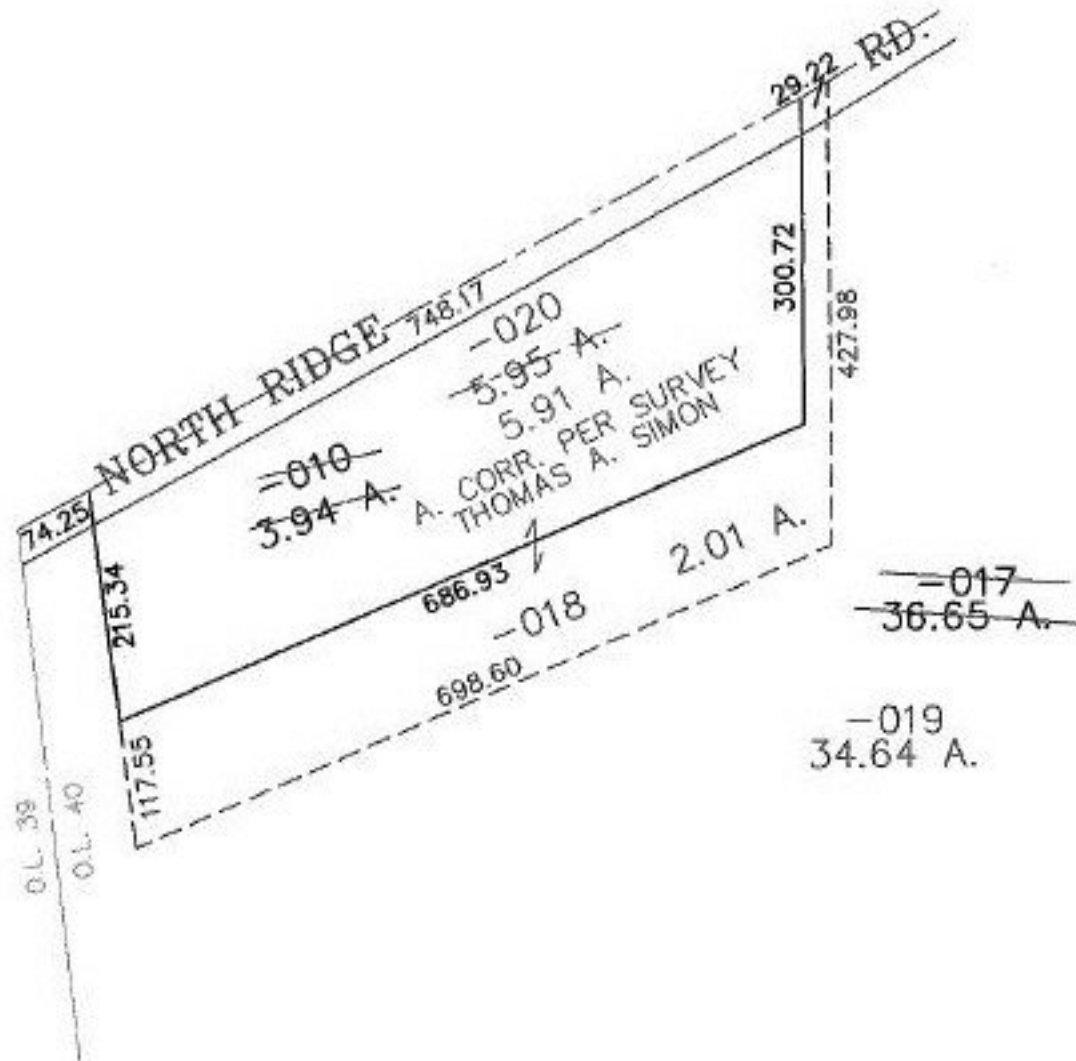

SPLITS/DEEDS PROCESSED
 LORAIN COUNTY TAX MAP DEPARTMENT
 226 MIDDLE AVE. ELYRIA, OHIO

SURVEYED BY: THOMAS A. SIMON
 CLOSURE: 0.00 : 10.000
 MAP PAGE(S): 1-H
 APPROVED BY: JAH DATE: 4-12-02
 SCALE: 1" = 200 PRIOR INSTRUMENT: DV 637/88