


PARENT PARCEL: 11-00-034-000-039, -038  
CHILD PARCEL: 11-00-034-000-052 THRU -054  
STARTING POINT: CENTERLINE OF COOLEY RD. & ISLAND RD.

NO. 01049

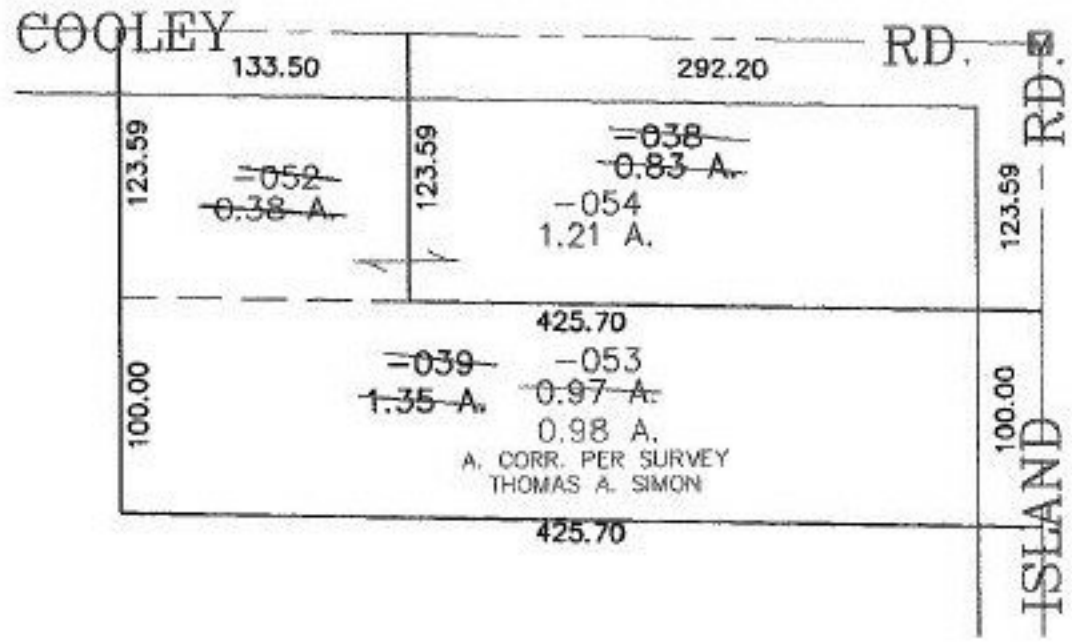

**SPLITS/DEEDS PROCESSED**

LORAIN COUNTY TAX MAP DEPARTMENT  
228 MIDDLE AVE. ELYRIA, OHIO

SURVEYED BY: 01049  
CLOSURE: 0.00 : 10.000  
MAP PAGE(S): 11-00-034-B  
APPROVED BY: JAH DATE: 4-17-02  
SCALE: 1" = 100' PRIOR INSTRUMENT: OR 1206/212