


#02-01053

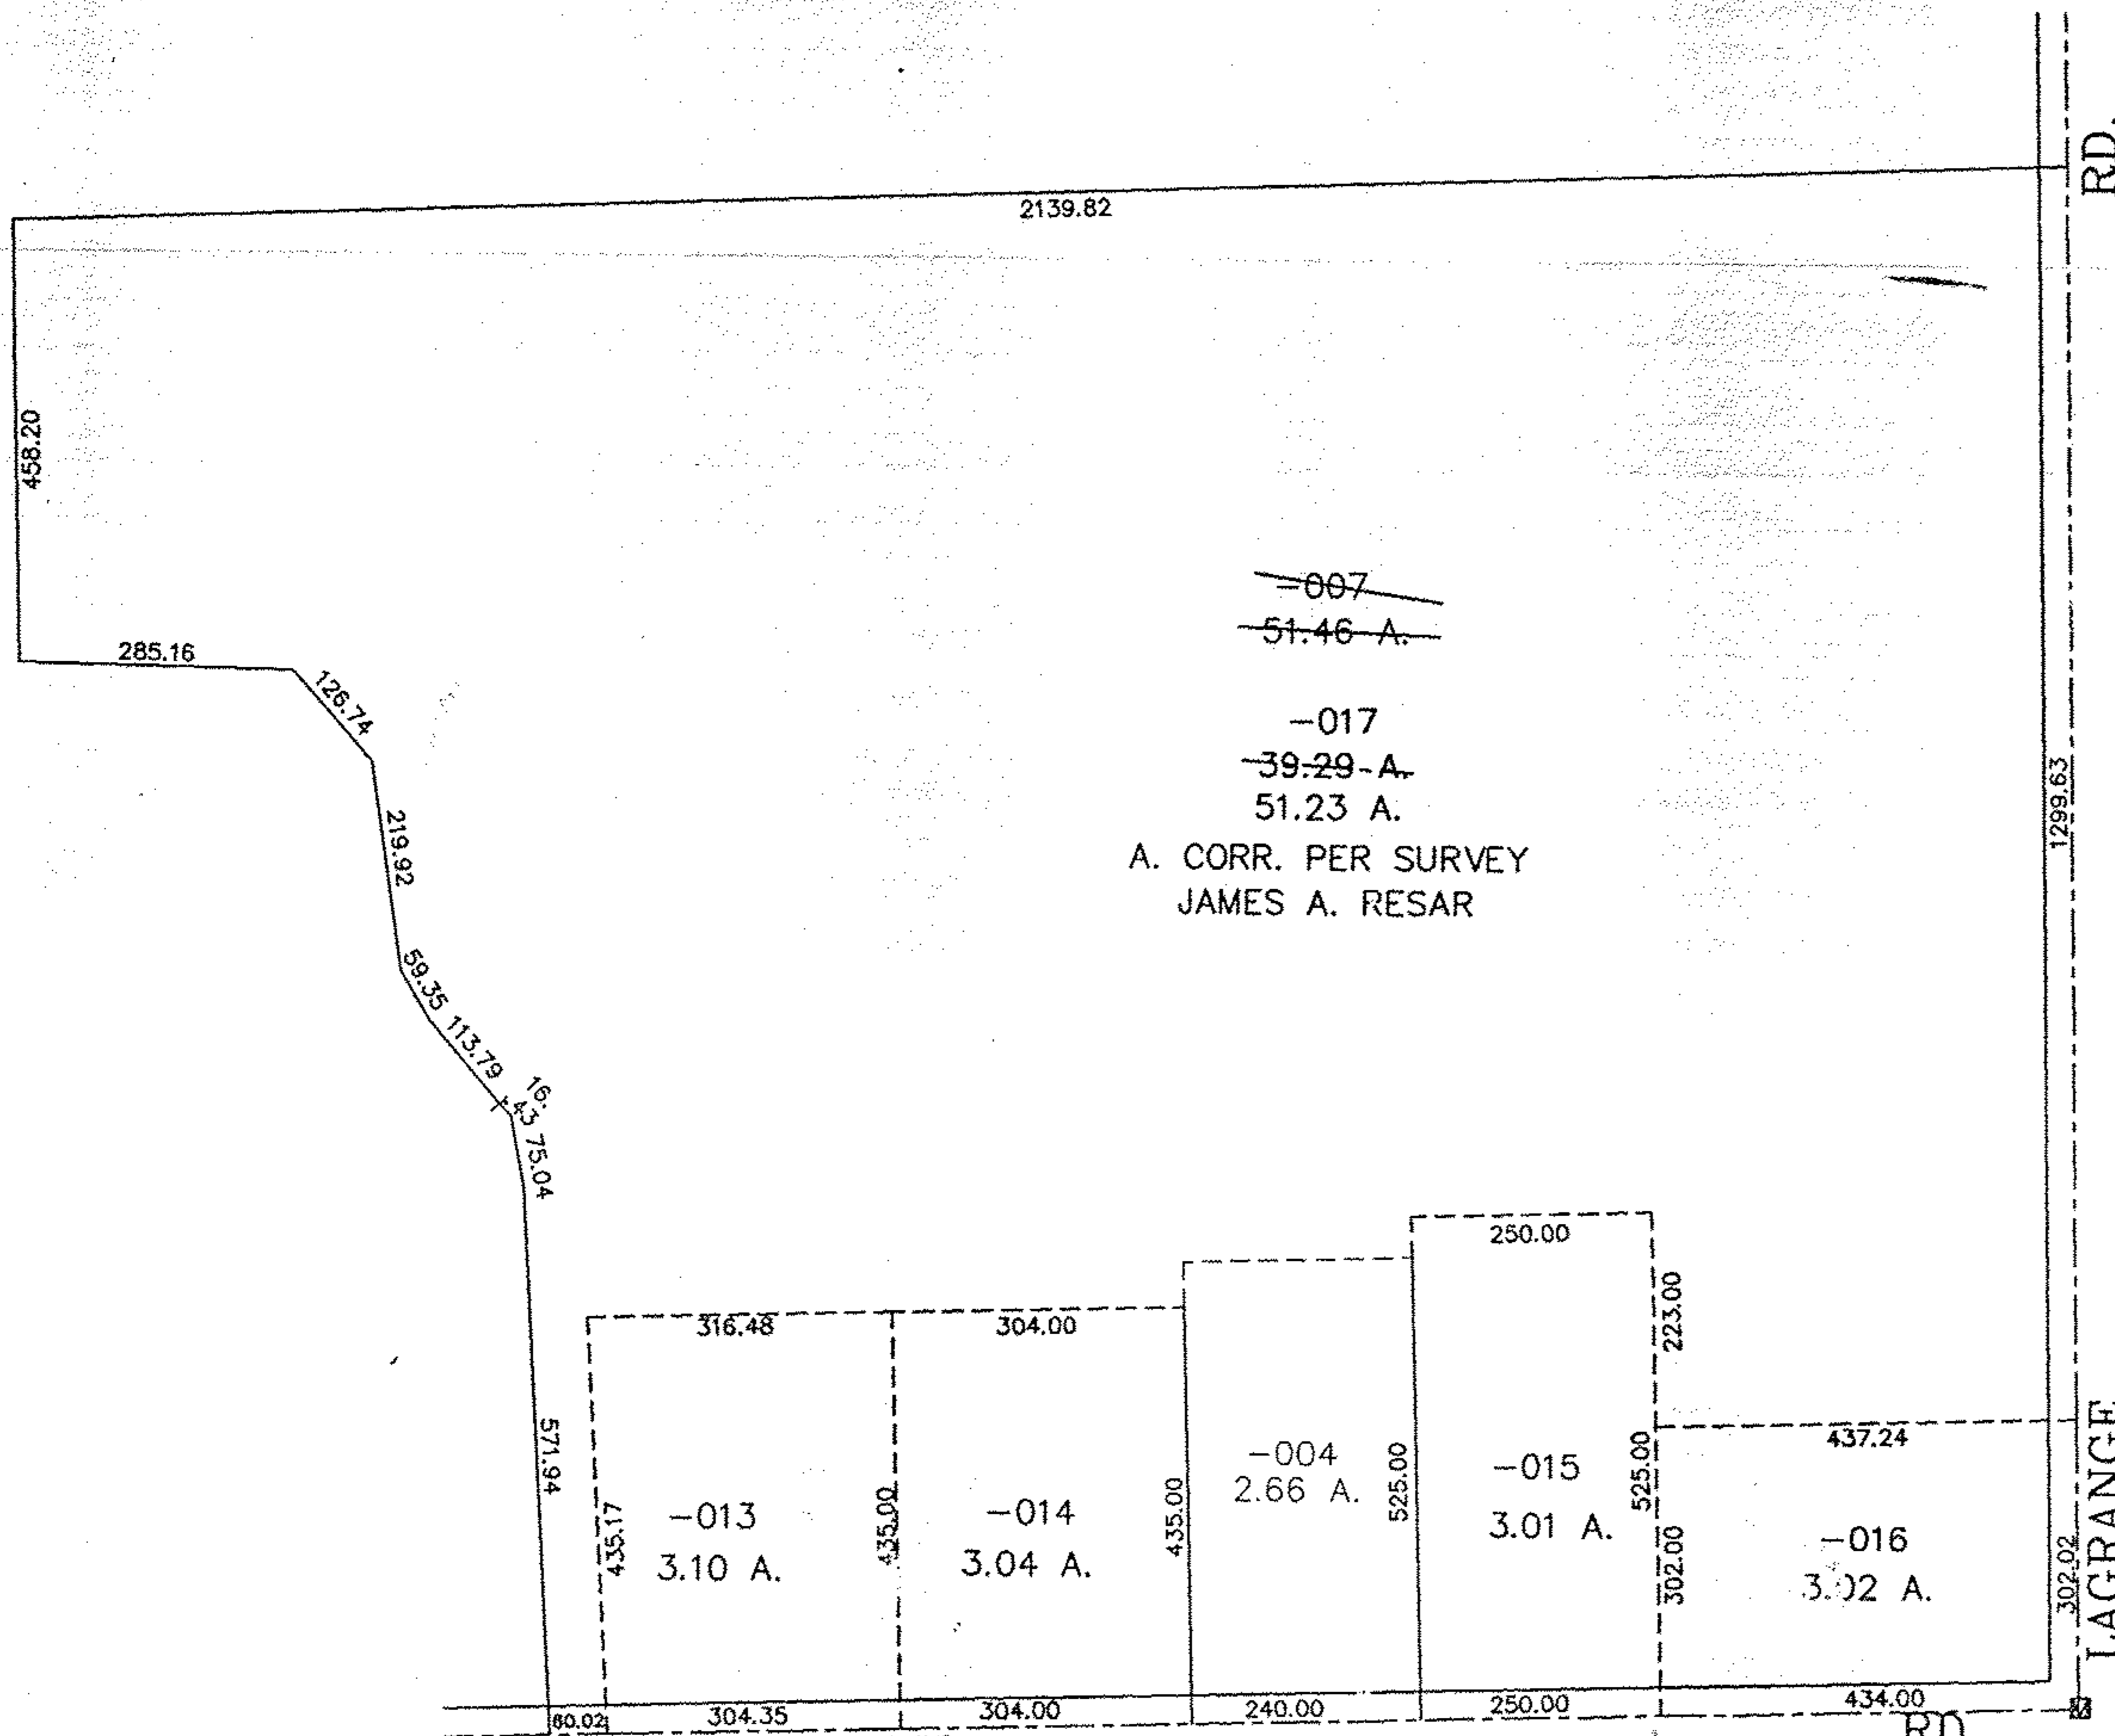

2139.82

458.20

285.16

126.74

219.92

59.35

113.79

16.43

571.94

-013  
3.10 A.

-014  
3.04 A.

-004  
2.66 A.

-015  
3.01 A.

-016  
3.02 A.

~~-007~~  
~~51.46 A.~~

-017  
~~39.29-A.~~  
51.23 A.

A. CORR. PER SURVEY  
JAMES A. RESAR

RD.

1299.63

LAGRANGE

PECK WADSWORTH

RD.