



RASTER

PARENT PARCEL: 03-00-012-000-167

CHILD PARCEL: 03-00-012-000-176, -177

STARTING POINT: CENTERLINE OF NORTH RIDGE RD. & ABBE RD.

NO. 01056

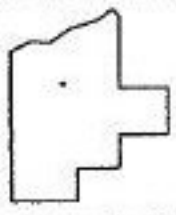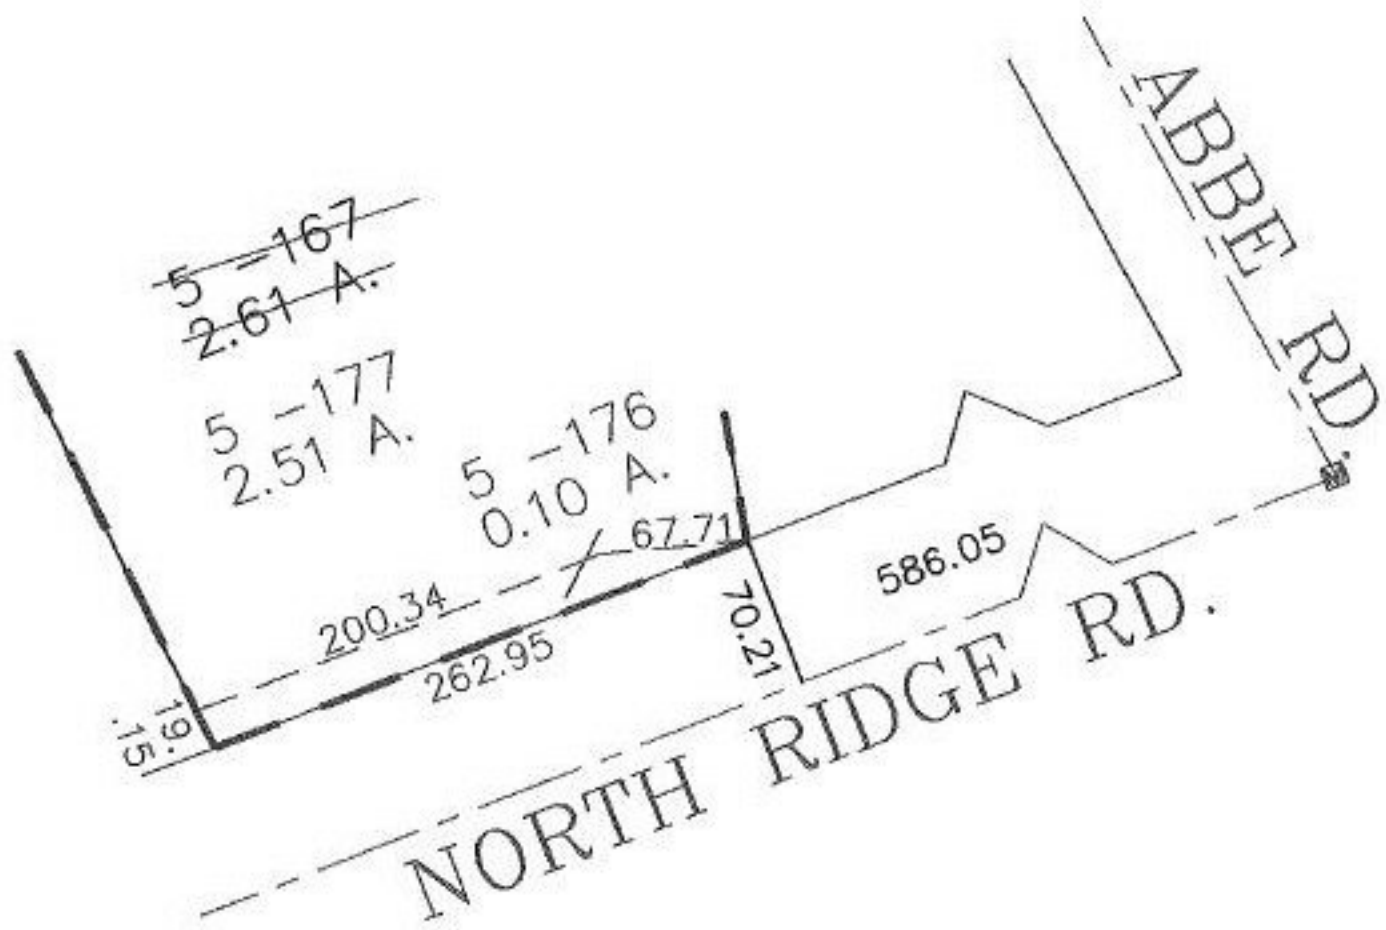

**SPLITS/DEEDS PROCESSED**

LORAIN COUNTY TAX MAP DEPARTMENT  
226 MIDDLE AVE. ELYRIA, OHIO

SURVEYED BY: MICHAEL STRAUB  
CLOSURE: 0.00 : 10.000  
MAP PAGE(S): 3-00-012-B  
APPROVED BY: JAH DATE: 4-22-02  
SCALE: 1" = 100' PRIOR INSTRUMENT: 97504947