
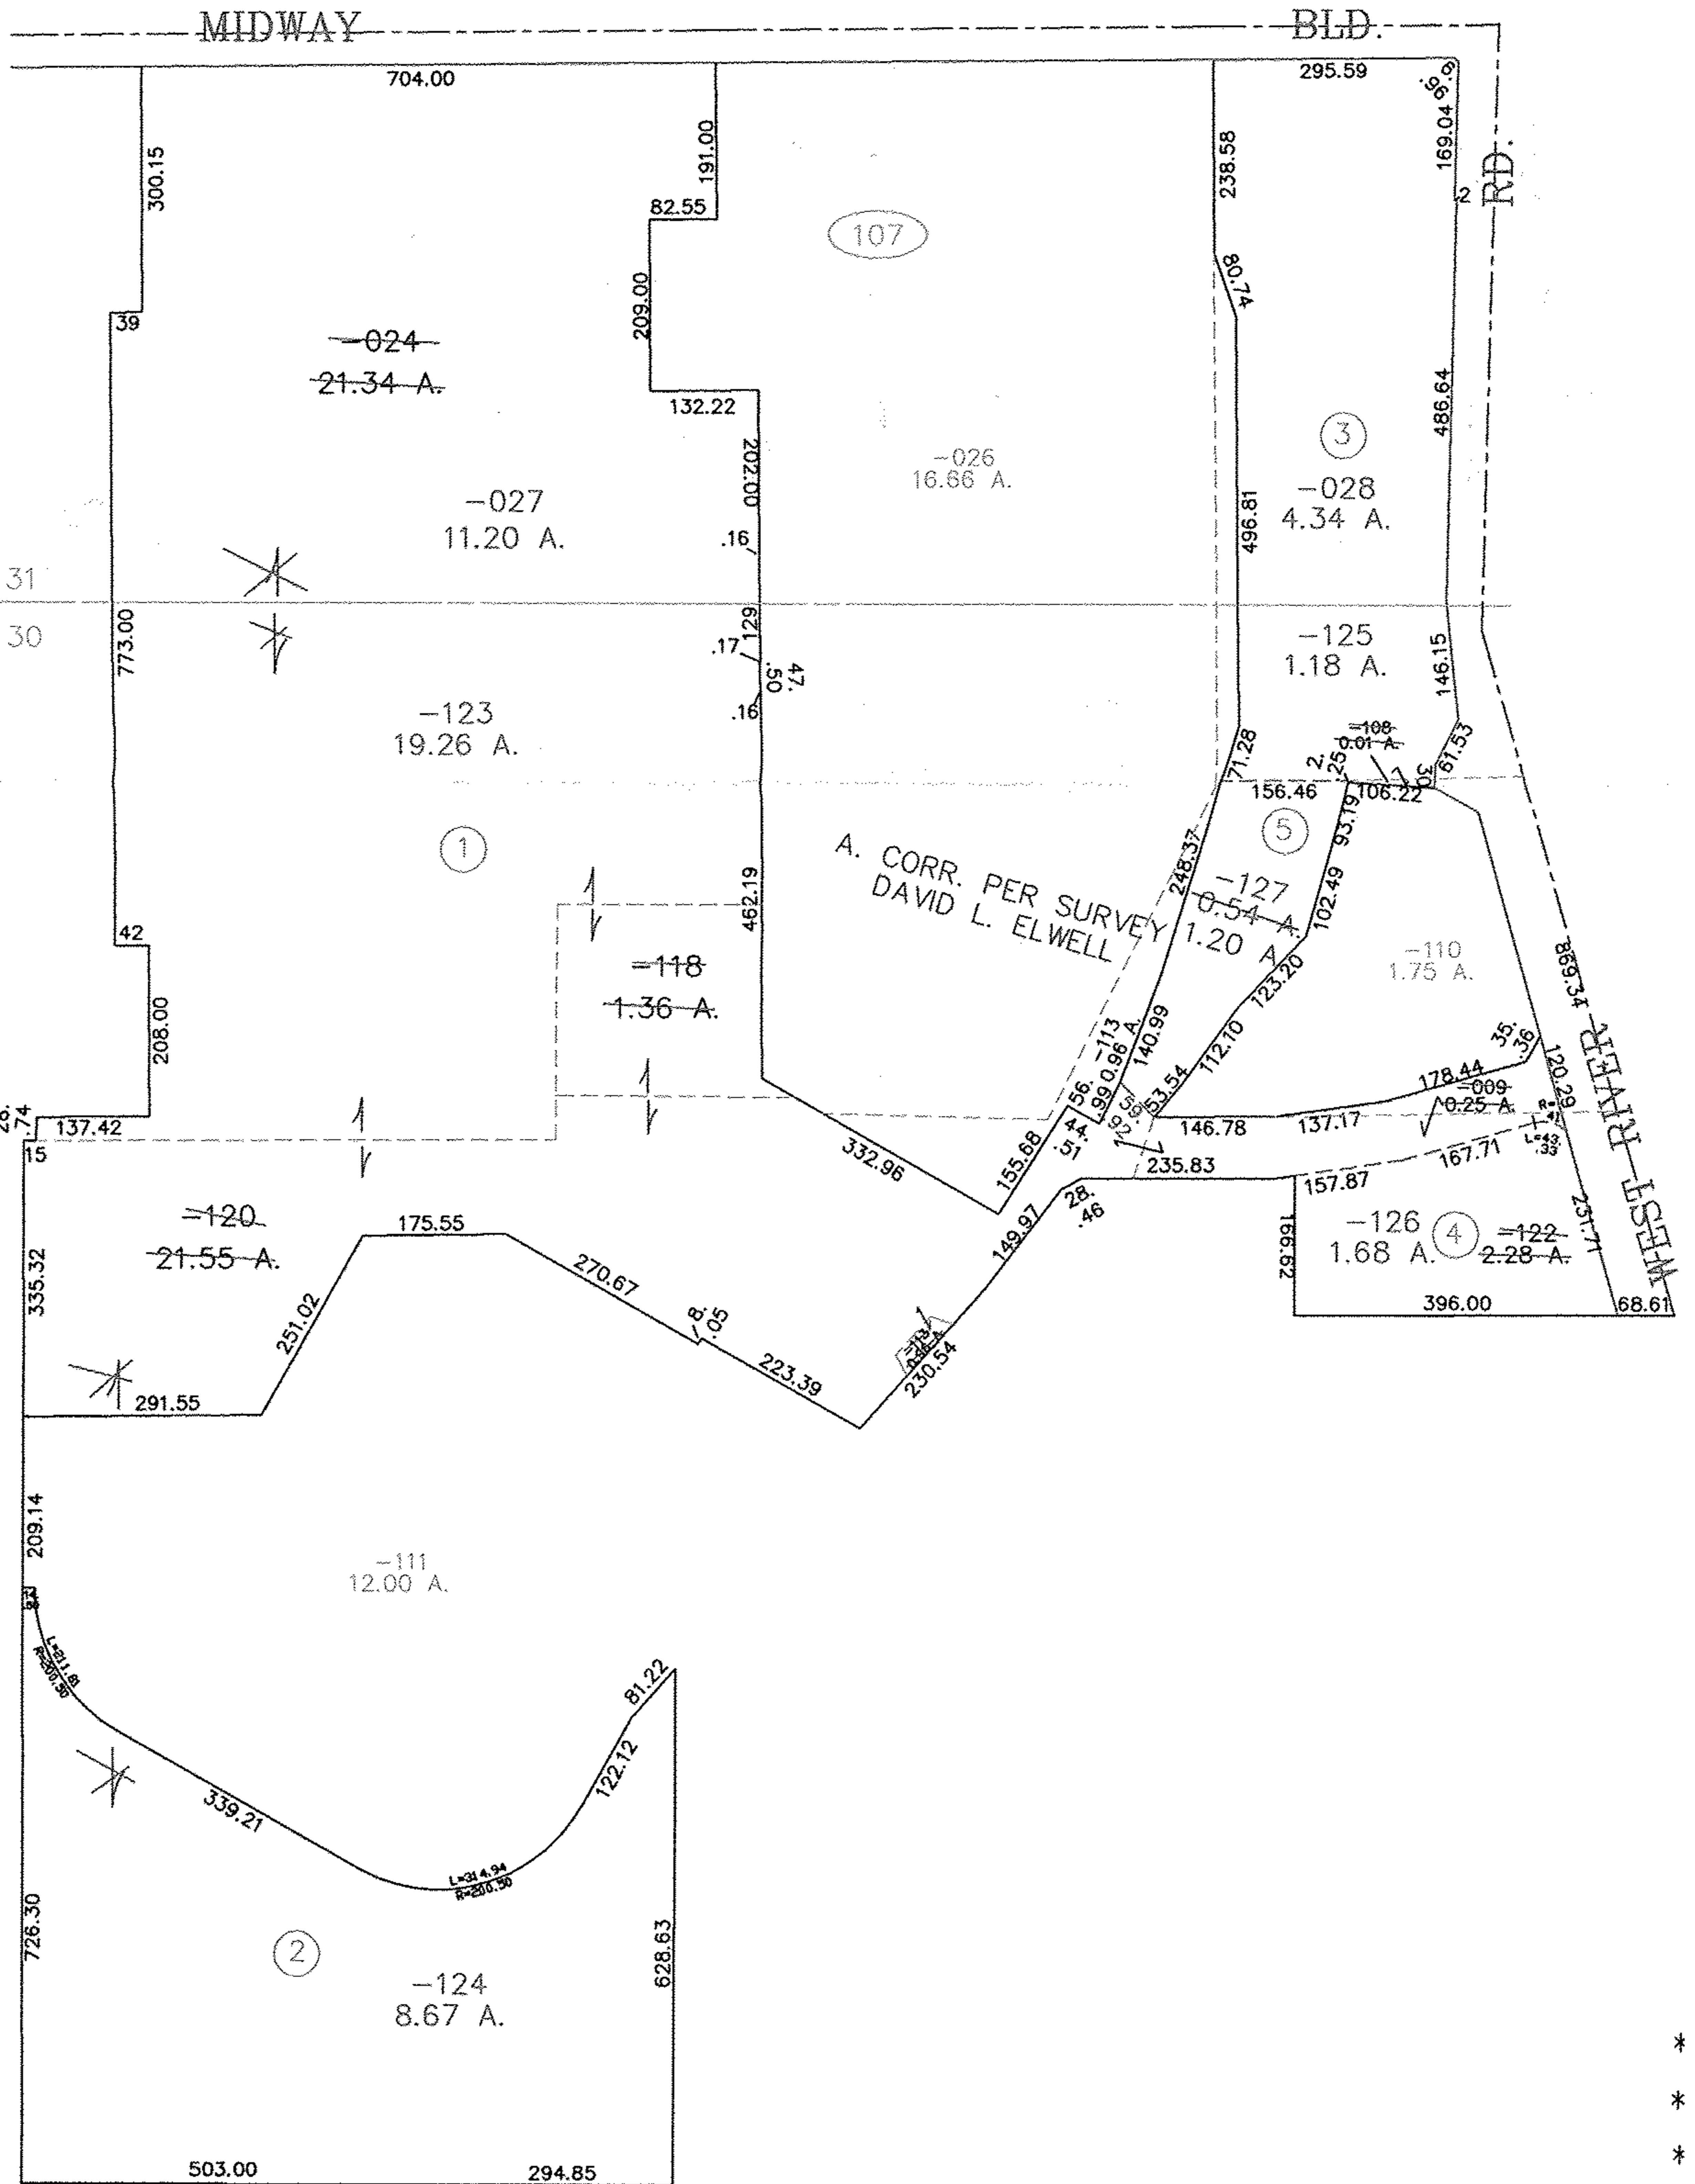


02-01059

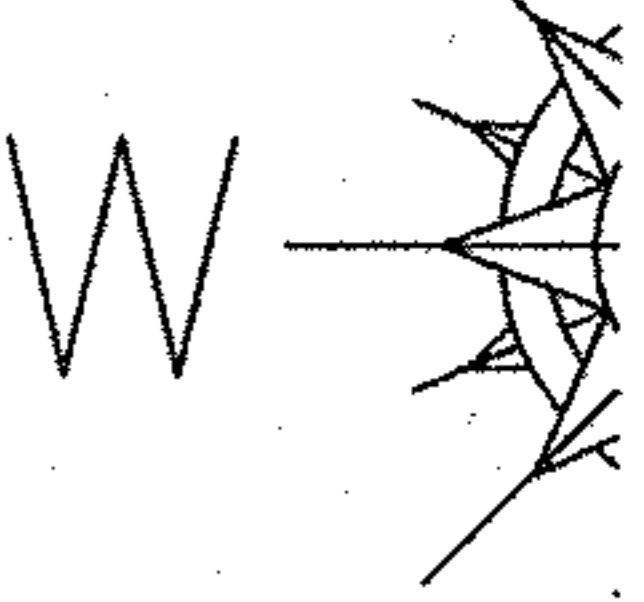

*
*
*
*