


PARENT PARCEL: 04-00-020-101-131  
CHILD PARCEL: 04-00-020-101-132 THRU -135  
STARTING POINT: CENTERLINE OF WALKER RD. & O.L. 20

NO. 01062

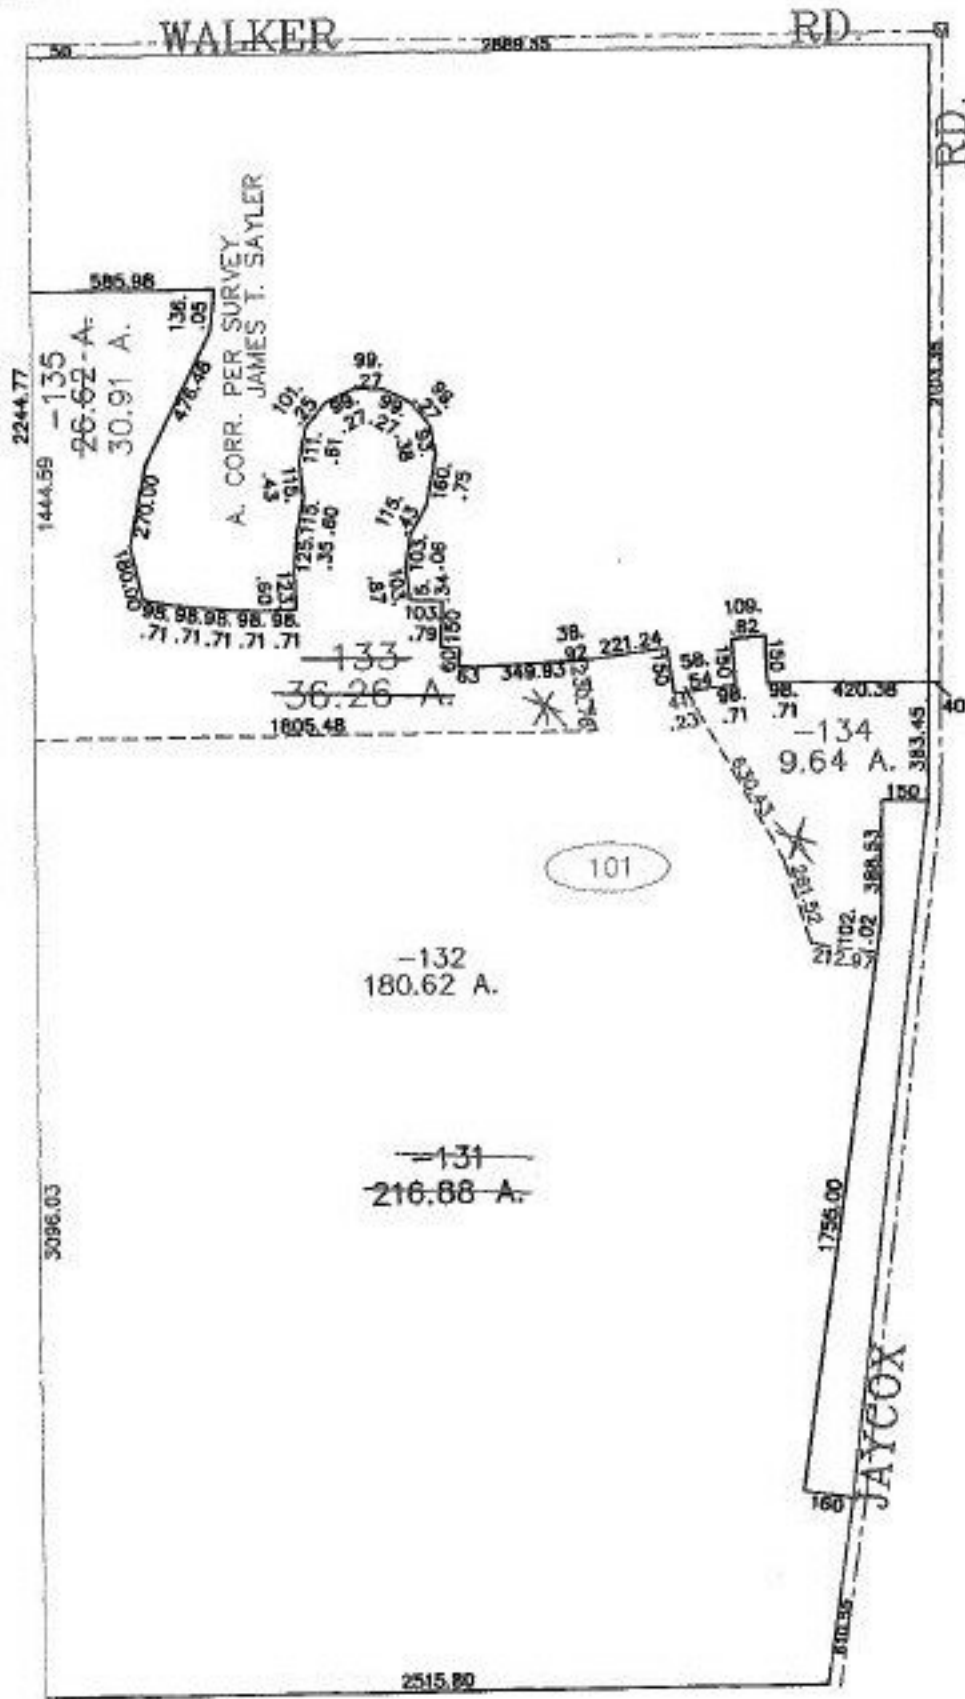

**SPLITS/DEEDS PROCESSED**

LORAIN COUNTY TAX MAP DEPARTMENT  
226 MIDDLE AVE. ELYRIA, OHIO

SURVEYED BY:	JAMES T. SAYLER
CLOSURE:	0.01 : 10.000
MAP PAGE(S):	4-00-020-G
APPROVED BY:	JAH DATE: 4-26-02
SCALE:	1" = 700 PRIOR INSTRUMENT: 20020803424