


EASTER

PARENT PARCEL: 04-00-013-000-029


CHILD PARCEL: 04-00-013-000-455, -456

STARTING POINT: CENTERLINE OF WOOSTER-AVON LAKE RD. & SOUTH PARK DR.

NO. 01066

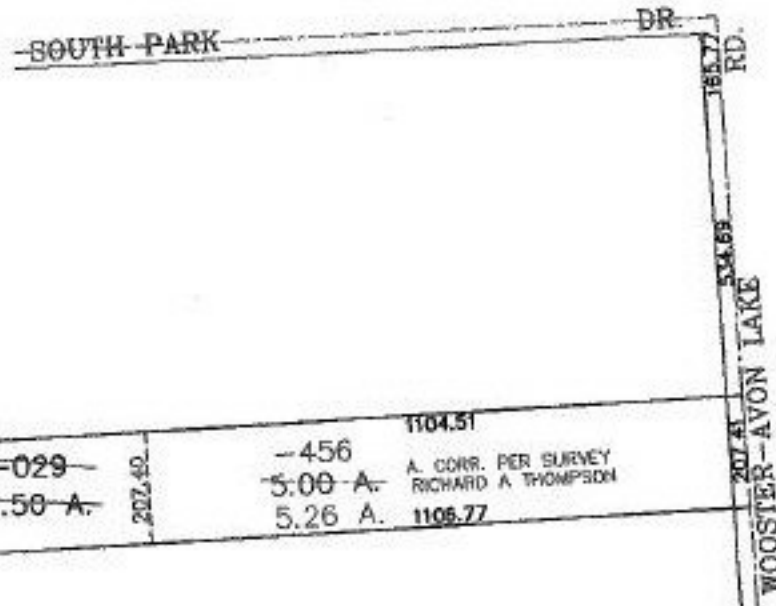

A. CORR. PER SURVEY
RICHARD A. THOMPSON

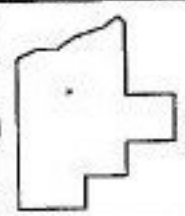

SPLITS/DEEDS PROCESSED
LORAIN COUNTY TAX MAP DEPARTMENT
226 MIDDLE AVE. ELYRIA, OHIO

SURVEYED BY: RICHARD A. THOMPSON
 CLOSURE: 0.00 ; 10.000
 MAP PAGE(S): 04-00-013-F
 APPROVED BY: JAH DATE: 5-8-02
 SCALE: 1" = 400' PRIOR INSTRUMENT: DV 1241/704