


PARENT PARCEL: 14-00-124-000-001

CHILD PARCEL: 14-00-124-000-003, -004

STARTING POINT: CENTERLINE OF HAWLEY RD. & O.L. 123, 124, 137, 138

NO. 01071

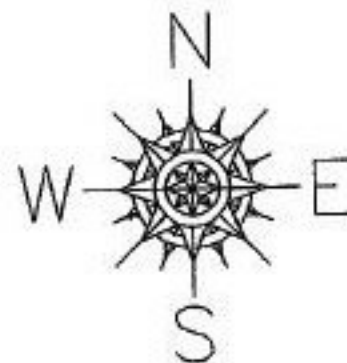

O.L. 118 O.L. 117  
O.L. 125 O.L. 124

WESTERLY BRANCH OF BLACK RIVER

325.75

430.24

885.32

~~-001~~  
98.33 A.

~~-004~~  
65.57 A.

1655.72

~~-003~~  
32.76 A.


188.05

518.76

2599.90

O.L. 125 O.L. 124  
O.L. 136 O.L. 137

RD.  
HAWLEY

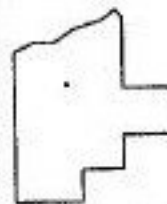

**SPLITS/DEEDS PROCESSED**  
LORAIN COUNTY TAX MAP DEPARTMENT  
226 MIDDLE AVE. ELYRIA, OHIO

SURVEYED BY: RODGER G. SIMON

CLOSURE: 0.00 : 10.000

MAP PAGE(S): 14-G

APPROVED BY: JAH DATE: 5-8-02

SCALE: 1" = 400' PRIOR INSTRUMENT: 20000694132