
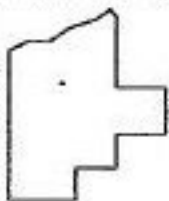


PARENT PARCEL: 03-00-058-101-041

CHILD PARCEL: 03-00-058-101-042, -043

STARTING POINT: CENTERLINE OF COLORADO AVE. & ROOT RD.

NO. 01074

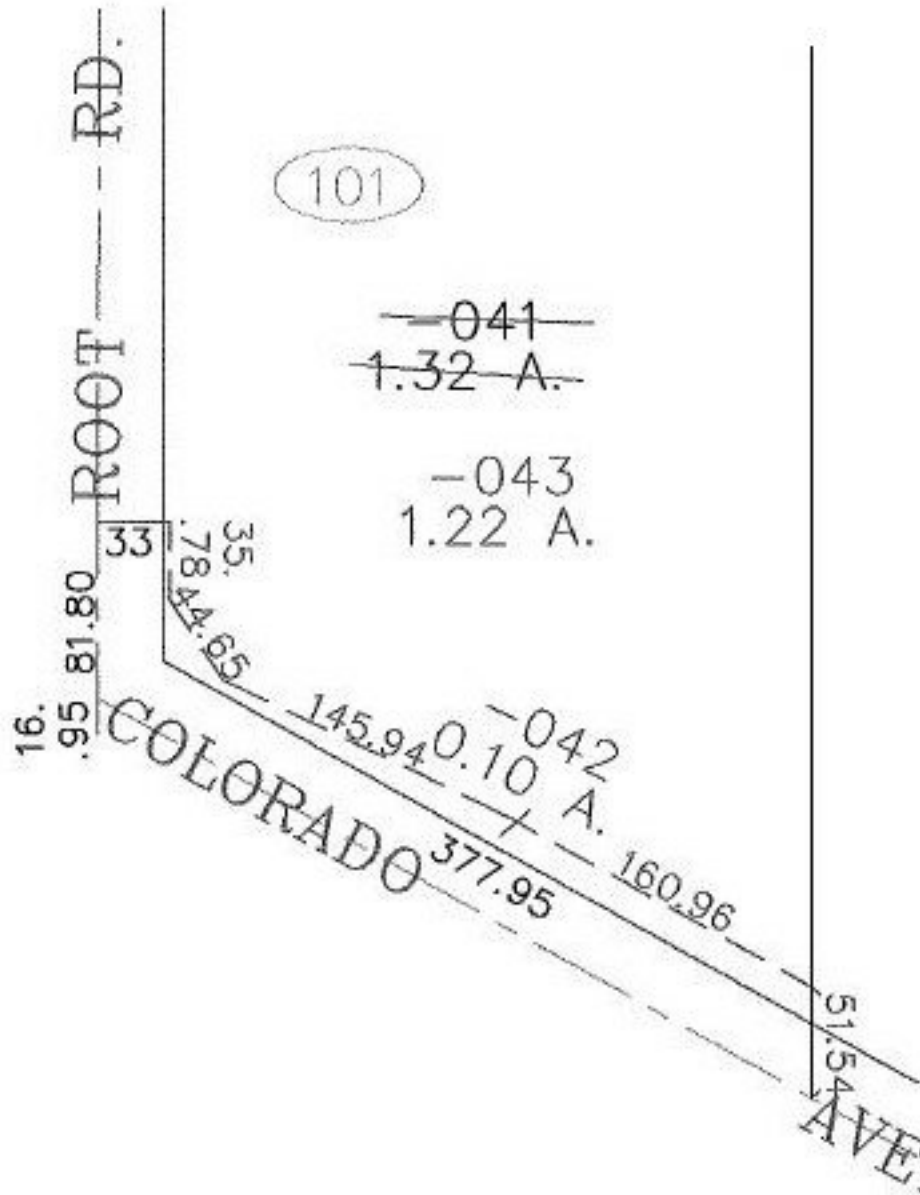

SPLITS/DEEDS PROCESSED

LORAIN COUNTY TAX MAP DEPARTMENT
226 MIDDLE AVE. ELYRIA, OHIO

SURVEYED BY: BRIAN P. MCCARTNEY

CLOSURE: 0.00 : 10.000

MAP PAGE(S): 3-00-058-A

APPROVED BY: JAH DATE: 5-6-02

SCALE: 1" = 100' PRIOR INSTRUMENT: 20000673369