
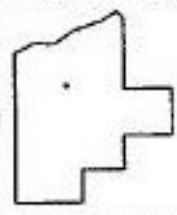


RASTER

PARENT PARCEL: 01-00-062-000-031  
CHILD PARCEL: 01-00-062-000-033, -034  
STARTING POINT: CENTERLINE OF BANK ST. & O.L. 62

NO. 01077

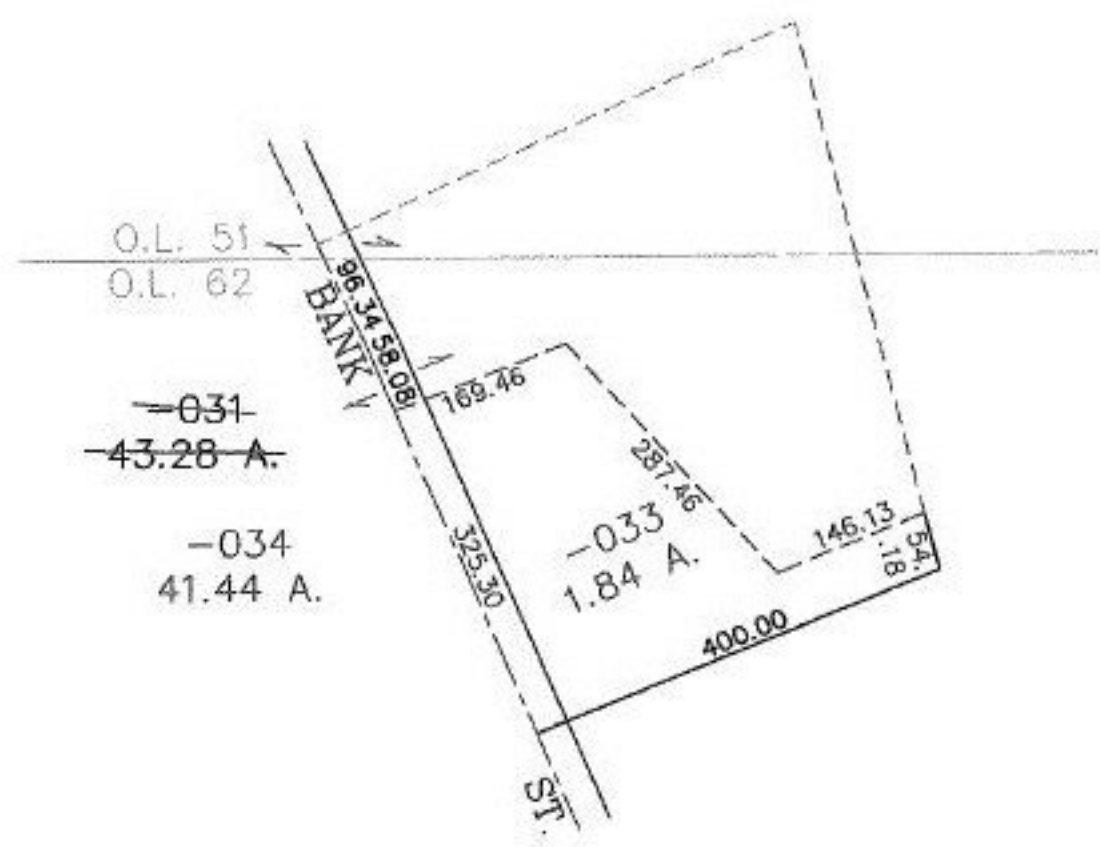

**SPLITS/DEEDS PROCESSED**  
LORAIN COUNTY TAX MAP DEPARTMENT  
226 MIDDLE AVE. ELYRIA, OHIO

SURVEYED BY: MIKE HURA  
CLOSURE: 0.00 : 10.000  
MAP PAGE(S): 1-J  
APPROVED BY: JAH DATE: 5-9-02  
SCALE: 1" = 200 PRIOR INSTRUMENT: OR 1201/550