

RASTER

PARENT PARCEL: 01-00-002-108-019, -021


CHILD PARCEL: 01-00-002-108-087 THRU -090

STARTING POINT: CORNER OF S/L 1285 OF VERMILION ON THE LAKE SUBD. NO. 1


NO. 01078



VERMILION ON THE LAKE
SUBD. NO. 1
VOL. 10 PG 18

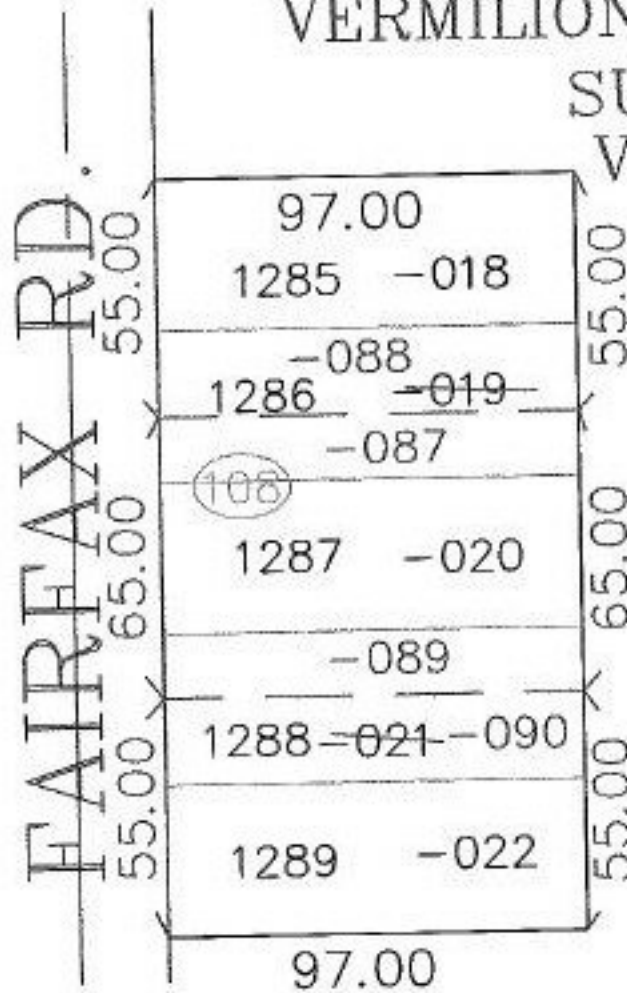

SURVEYED BY: M.G. HURA
 CLOSURE: 0.00 : 10.000
 MAP PAGE(S): 1-00-002-B
 APPROVED BY: JAH DATE: 5-30-02
 SCALE: 1" = 50' PRIOR INSTRUMENT: 20010739535

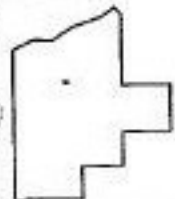

SPLITS/DEEDS PROCESSED
 LORAIN COUNTY TAX MAP DEPARTMENT
 226 MIDDLE AVE. ELYRIA, OHIO