


RASTER

NO. 01079

PARENT PARCEL: 03-00-012-000-167

CHILD PARCEL: 03-00-012-000-178, -179

STARTING POINT: CENTERLINE OF NORTH RIDGE RD. & ABBE RD.

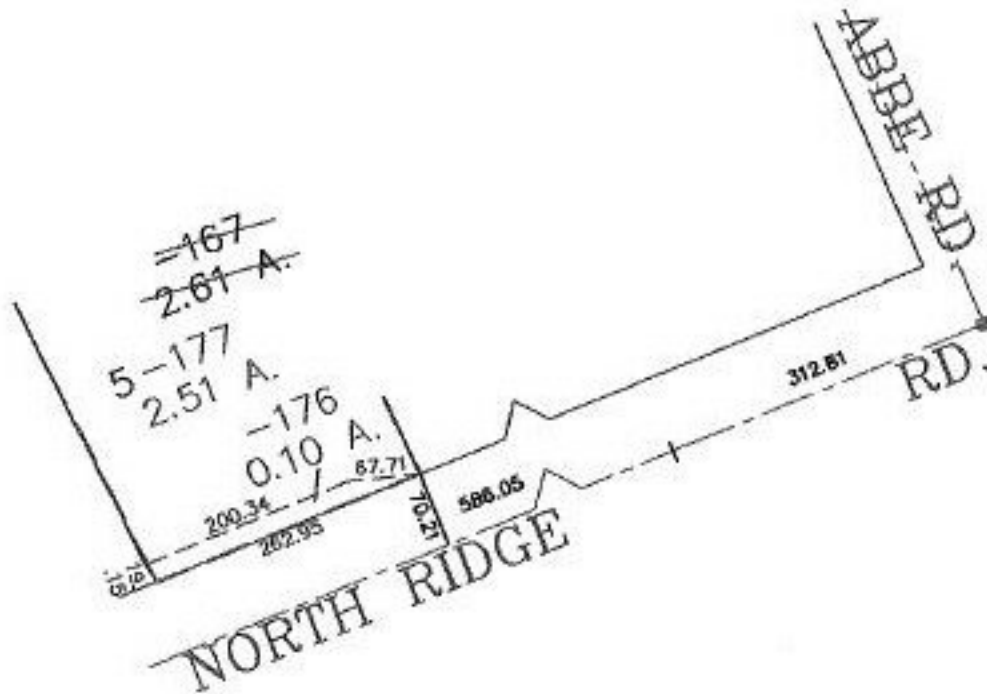

SPLITS/DEEDS PROCESSED
 LORAIN COUNTY TAX MAP DEPARTMENT
 226 MIDDLE AVE. ELYRIA, OHIO

SURVEYED BY: MICHAEL A. STRAUB

CLOSURE: 0.00 : 10.000

MAP PAGE(S): 3-00-012-B

APPROVED BY: JAH DATE: 5-13-02

SCALE: 1" = 200' PRIOR INSTRUMENT: 970504947