
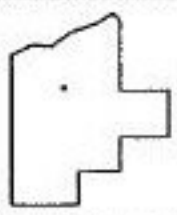


PARENT PARCEL: 01-00-018-000-008

CHILD PARCEL: 01-00-018-000-075, -076

STARTING POINT: CENTERLINE OF HIGHBRIDGE RD. & BROWNHELM STATION RD.

NO. 01080

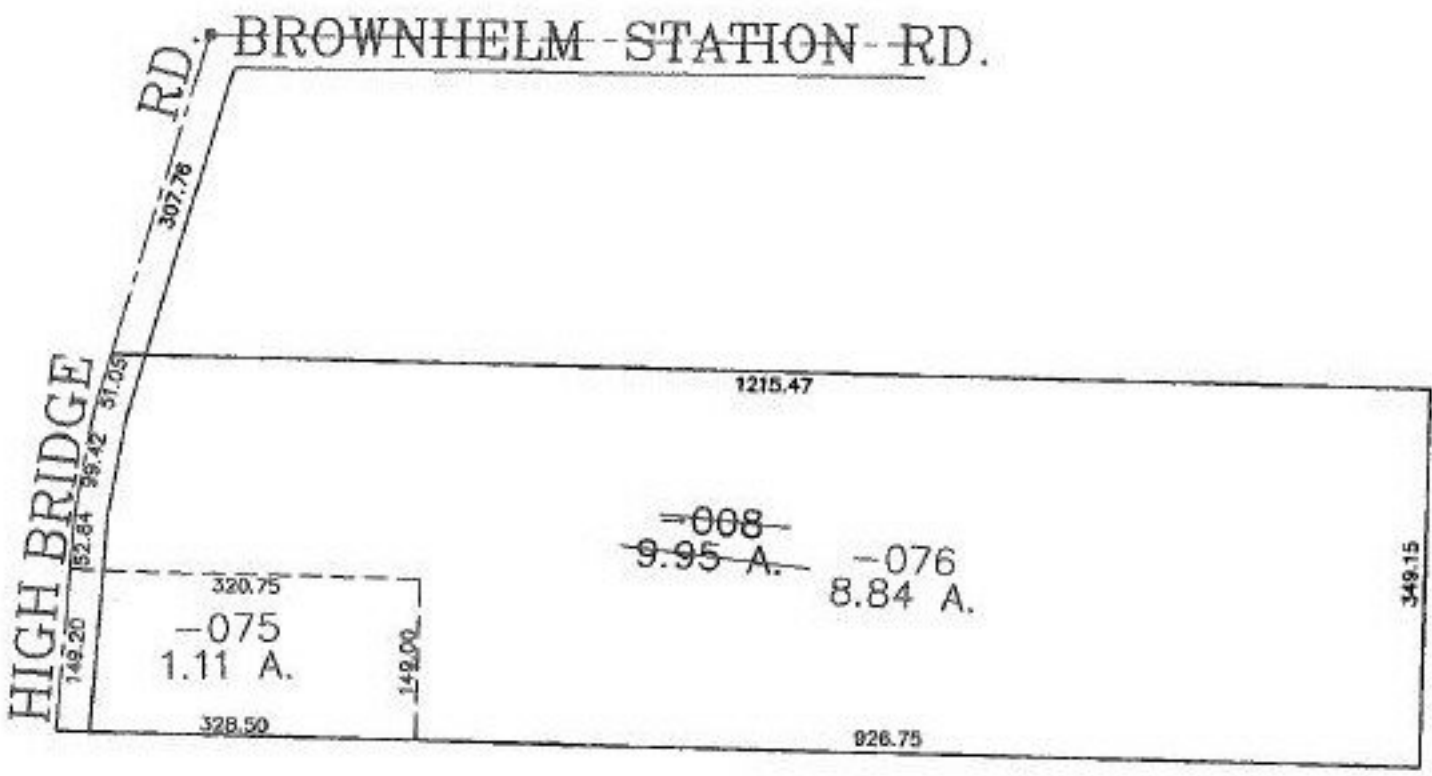

**SPLITS/DEEDS PROCESSED**  
 LORAIN COUNTY TAX MAP DEPARTMENT  
 226 MIDDLE AVE. ELYRIA, OHIO

SURVEYED BY: M.G. HURA  
 CLOSURE: 0.00 : 10.000  
 MAP PAGE(S): 1-00-018-A  
 APPROVED BY: JAH DATE: 5-14-02  
 SCALE: 1" = 200' PRIOR INSTRUMENT: OR 1438/1100