



EASTER

PARENT PARCEL: 07-00-031-000-009

CHILD PARCEL: 07-00-031-000-061 THRU -063

STARTING POINT: CENTERLINE OF MILLS RD. & STONEY RIDGE RD.

NO. 01090

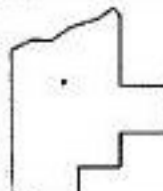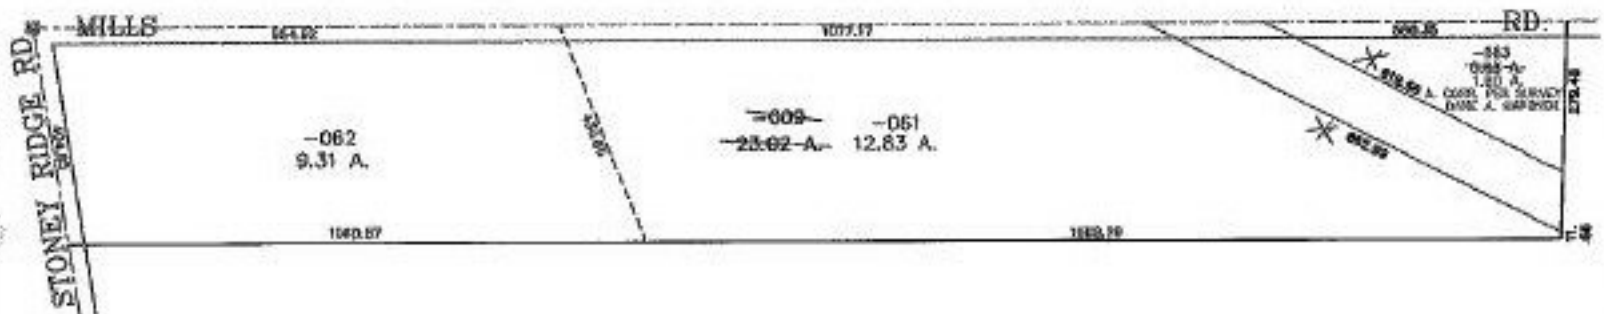

SPLITS/DEEDS PROCESSED
LORAIN COUNTY TAX MAP DEPARTMENT
 226 MIDDLE AVE. ELYRIA, OHIO

SURVEYED BY: DANE A. HAPONEK
 CLOSURE: 0.01 : 10,000
 MAP PAGE(S): 7-B
 APPROVED BY: JAH DATE: 5-23-02
 SCALE: 1" = 400 PRIOR INSTRUMENT: DV 1360/709