

RASTER

PARENT PARCEL: 04-00-023-102-018



CHILD PARCEL: 04-00-023-102-033, -034 04-00-014-107-220

STARTING POINT: CENTERLINE OF JAYCOX RD. & O.L. 23

NO. 01093



O.L. 15 O.L. 22
O.L. 14 O.L. 23

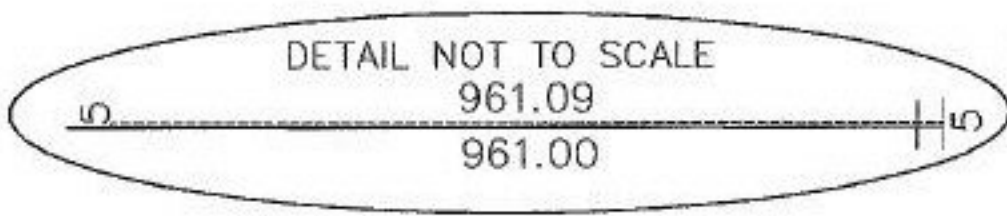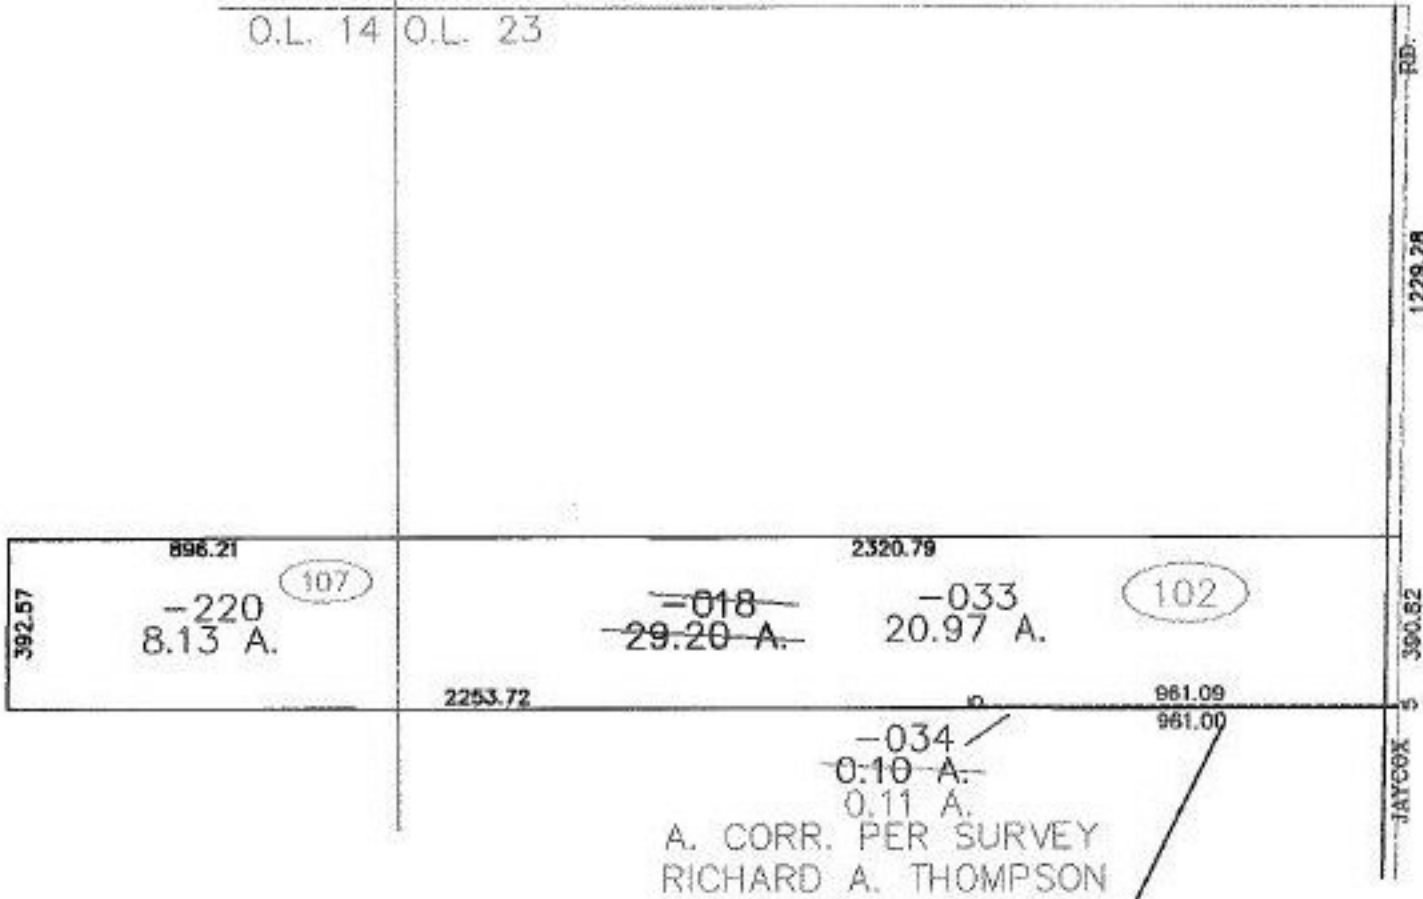

SPLITS/DEEDS PROCESSED

LORAIN COUNTY TAX MAP DEPARTMENT
226 MIDDLE AVE. ELYRIA, OHIO

SURVEYED BY: RICHARD A. THOMPSON

CLOSURE: 0.00 : 10.000

MAP PAGE(S): 04-00-014-D, 04-00-023-A, B

APPROVED BY: JAH DATE: 6-12-02

SCALE: 1" = 500. PRIOR INSTRUMENT: 20000661988