


RASTER

PARENT PARCEL: 04-00-023-102-020

CHILD PARCEL: 04-00-014-107-003, 04-00-023-102-035, -036

STARTING POINT: CENTERLINE OF JAYCOX RD. & O.L. 23

NO. 01094

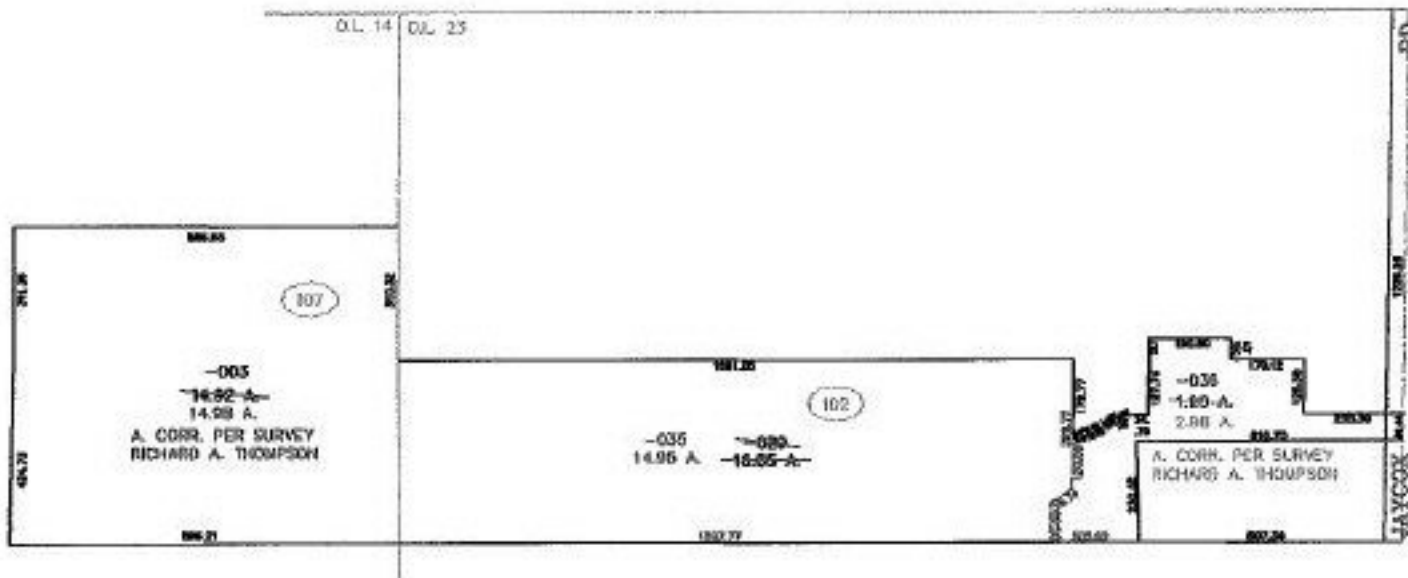

SPLITS/DEEDS PROCESSED

LORAIN COUNTY TAX MAP DEPARTMENT
226 MIDDLE AVE. ELYRIA, OHIO

SURVEYED BY: RICHARD A. THOMPSON

CLOSURE: 0.00 : 10.000

MAP PAGE(S): 04-00-014-D, 04-00-023-A,B

APPROVED BY: JAH DATE: 6-13-02

SCALE: 1" = 500' PRIOR INSTRUMENT: OR 1036/292